Paper weight- 32# 25% Rag Ledger (minimum)

Black nonfading introduced

U.S.

## SURVEY -UBLIC RECORD MONUMENT

For Public Land Survey Corners in the T. 3 N., R. 1/ E

CORNER CODE INDEX

7 6 10 12 9 HJELMHOPORSTUVW 17 18 10 20 19 2/2 27 28 2) 20 3O zb.

POR	TER	TWP
ROCK	COUNTY	WI

TE AVAILABLE ROCK COUNTY COORDITIATES PERFERRED		
North	Elev.	
East		
Hor. Date	um Vert. Datum	
GPS (X)	TRAVERSE (x)	
BASED ON T	HE FOLLOWING CONTROL:	

PLACE MONUMENT SYMBOL •
LOCATION ON ABOVE INDEX

CORDER MONUMENT

O WITHESS MONUMENT


BEARINGS ARE BASED ON:

(a)

FIELD BOOK PAGE #  SHOW A PLAN VIEW DRAWLING DEPICTING THE COTHER MONDMENT AND SUPPROUNDING PHYSICAL FEATURES. THE FOLLOWING CHARACTERISTICS: 11 HAVE A LEAST TWO PREDETERMINED BREAK-CET FOILITS. 21 IF B 21 MUST BE EXTENDABLE. 41 THE CAP IS THISCRIEDED FROM COUNTY SURVEY MONAMENT - PENALTY FOR A BITHINDAN MAY BE USED 11 AMEAS MERE GROUND WATER IS WITHIN ONE FOOL OF THE SUPFACE, IF DURABLE, DISTINCT MONAMENT HAN BE USED. CONTERNS SHALL BE PEFEPPENCED WITH AT LEAST 4 DURABLE STOWELFROM OR OTHER BOUNDLY DURABLE MATERIAL E-CEPT WOOD. DESCRIBE THE CORNER AND THE WITH	DISTURBING MARKER: 5) OR AN EXISTING OUT LINESTONE. AN IRON PIPE 1 1/2"Y THE CORNER IS OCCUPIED BY AN IMPROVENENT BIAH-POLEBURIED CABLEETCI AND LE WITHESS MODIFIEDS. WITHESS MONOMENTS SHALL BE MADE OF CONCRETE, MATURAL
STONE, IRON OR OTHER EQUALLY DURABLE MATERIAL E-CEPT WOOD LESSOCIAE THE OWNER WAS A STANDARD ON A PAIN OF A STANDARD OF OF	SHEETOF

CLAINDING & ZONDING COMMITTEE ADOPTED THE ABOVE FORM OF 12/2/1982 WI ADMINISTRATIVE CODE A-E 7.08 REQUIREMENT

CORNER CODE

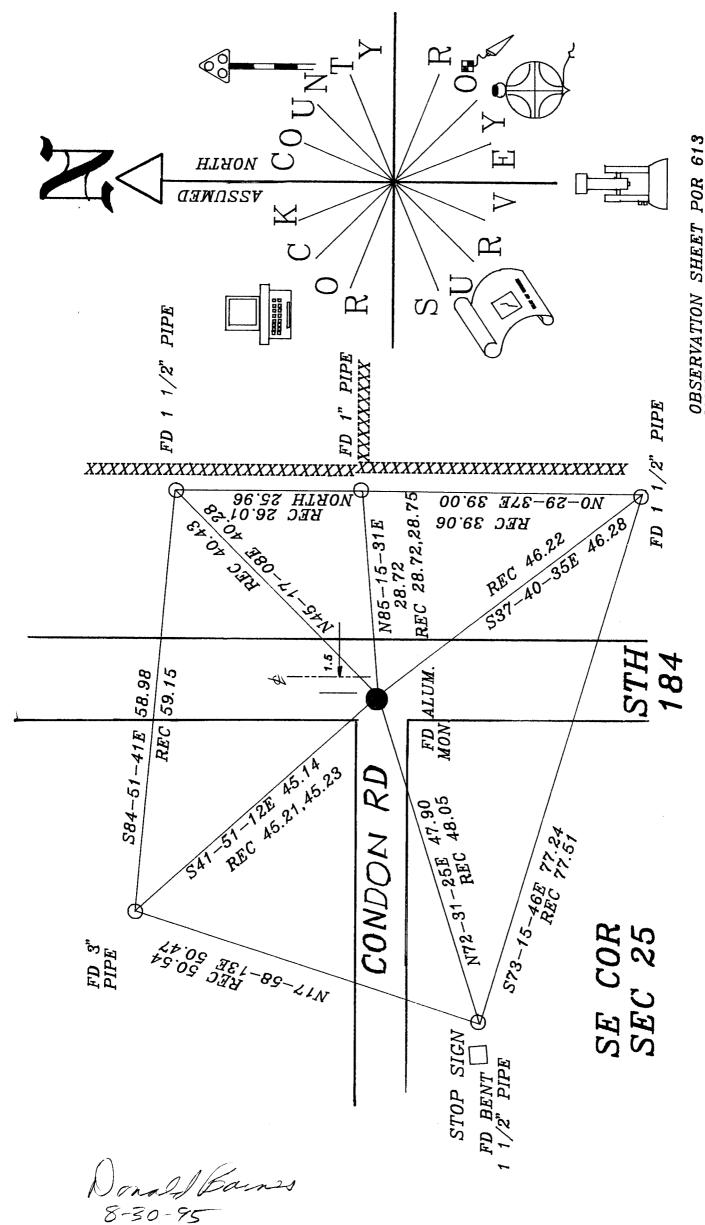

OBSERVATION SHEET MONUMENT WILL BE DISTURBED BY ROAD CONSTRUCTION

- (B) Describe any record evidence, monument evidence, occupational evidence, testimonial evidence or any other material evidence you considered, and whether the monument was found or placed. FOUND MONUMENT AS SHOWN IN DRAWING.
- C) Was the corner restored through acceptance of (1) an obliterated evidence location, or, (2) a found perpetuated location?
  THE MONUMENT WILL BE DISTURBED BY ROAD CONSTRUCTION. CORNER PERPETUATED AS FOUND.
- D) Describe any material discrepancy between the location of the corner as restored or reestablished and the location of that corner as previously restored or reestablished by distance and direction. Show the discrepancy on the plan view drawing under (a), above. Show the distances between the corner as previously restored or reestablished and (1) the corner as restored or reestablished, and (2) to at least 4 of the witness monuments shown on the drawing in (a), above.
- (E) Was the corner reestablished through lost corner proportionate methods? If so, show the method, including the directions and distances to other public land survey corners used as evidence or used for proportioning the corner location.

I, Donald Barnes, hereby certify that the corner points as identified by the corner code index were, in a field survey on, JULY 31,1995, established, re-established, monumented, re-monumented, recovered or restored as expressed below and in conformance with the regulations and rules as required in the current manual of survey instructions of the United States Department of Interior, Bureau of Land Management.

COUNTY SURVEYOR FILING DATA

Date of computer entry\_\_\_\_\_

Date microfilmed \_\_\_\_\_

Number of included sheets \_\_\_\_\_

CORNER CODE

Conad Barnos
EMBOSS LAND SURVEYOR SEAL

seal

A-E 7.08 REQUIREMENT

V25

EMBOSS LAND SURVEYOR SEAL 8-38-95