

Paper weight-110# (minimum)

Black nonfading ink required

U.S. PUBLIC LAND SURVEY MONUMENT RECORD

For Public Land Survey Corners In:
T. 4 N. R. 11 E. 4th P.M.
CORNER CODE INDEX

WI ADMINISTRATIVE CODE A-E 7.08 REQUIREMENT
REV 10/23/2004 USMONREC.DWG

PORTER TWP
ROCK COUNTY WI

IF AVAILABLE
ROCK COUNTY COORDINATES PREFERRED

	1	2	3	4	5	6	7	8	9	10	11	12	13	14	15	16	17	18	19	20	21	22	23	24	25		
A																											A
B																											B
C																											C
D																											D
E																											E
F																											F
G																											G
H																											H
J																											J
K																											K
L																											L
M																											M
N																											N
O																											O
P																											P
Q																											Q
R																											R
S																											S
T																											T
U																											U
V																											V
W																											W
X																											X
Y																											Y
Z																											Z

North _____ Elev. _____

East _____

Hor. Datum _____ Vert. Datum _____

LATITUDE _____ ELLIPS. HT. _____

LONGITUDE _____

NAD83(91) _____ NETWORK ADJ. YR _____

GPS (X) _____ TRAVERSE (X) _____

BASED ON THE FOLLOWING CONTROL:

PLACE MONUMENT SYMBOL AT PROPER LOCATION ON ABOVE INDEX

CORNER MONUMENT

WITNESS MONUMENT

(a)

BEARINGS ARE BASED ON: _____

FIELD BOOK _____ PAGE # _____

SHEET 1 OF 2

SHOW A PLAN VIEW DRAWING DEPICTING THE CORNER MONUMENT AND SURROUNDING PHYSICAL FEATURES, INCLUDING THE EXCAVATION AREA AND DEPTH.

PLANNING & ZONING COMMITTEE ADOPTED THIS FORM ON 12/2/1982

CORNER CODE 69(1)

PO536 E1/4COR-SEC8

(B) Describe any record evidence, monument evidence, occupational evidence, testimonial evidence or any other material evidence you considered, and whether the monument was found or placed.

- 1833 HARRISON (NOV) T4N R11E 4TH MER. NORTH
BET. 8 & 9
231.00 LEAVE PRAIRIE
2640.0 QUARTER SEC COR
{BURR OAK 12 N58W 87.12'; BURR OAK 10 S62W 198.0' {BURR OAK 12; BURR OAK 10} MARKED
5115.0 CREEK 19.8' CRS S.E.
5280.0 SET COR TO SECS 4,5,8,9
BURR OAK 12 N84E 119.46'; RED OAK 12 S56E 140.58'; BURR OAK 10 N54W 82.5'
LAND ROLLING 2ND RATE WITH HEAVY BURR & WHITE OAK TIMBER ?? ??? GRASS & WEEDS
- 1870 RUGER VOL 2 PG 25 FOUND OLD STAKE ALSO FOUND BEARING TREES. SET HH 9X4X3 CALLS FOR 2696.76' TO CENTER OF 8.
- 1892 BLEEDHORN VOL 2 PG 465 FOUND REMAINS OF OLD STAKE & HH SET BY RUGER. SET HH SURROUNDED BY 4 HHS. CALLS FOR 2664.42 TO SE CORNER OF SECTION 8.
- 1970 COMBS CSM VOL 1 PG 289 DUG LARGE HOLE FD NOTHING. SET 1" PIPE AT OCCUPATION.
- 1973 LEE VOL 4 PG 597 FOUND 1" IRON PIPE & NO STONES. SET ALUM. MON. FROM FD PIPES. REFERENCED SAME.
- 1978 BARNES VOL 5 PG 498 SET ALUM MON. FROM FOUND REFERENCE PIPES.
- 1984 COMBS CSM VOL 11 PG 620 FD ALUM. MON. USED TO SUBDIVIDE SEC 8. SET R/R @ CENTER OF SEC 8
- 1993 BARNES G-9 FOUND ALUM MONUMENT. ACCEPTED FOUND PERPETUATED LOCATION. REFERENCED SAME. 2' WEST OF CENTER OF PVMT. ON LINE WITH E/W FENCE LINE TO THE WEST.
- 1993 KARNS CSM VOL 16 PG 478 5305.91 TO W 1/4 COR SEC 8 STATES NOTHING ABOUT MON.
- 1998 COMBS CSM VOL 22 PG 187 ALUM 5284.90 TO PK @ E 1/4 COR SEC 9

FD ALUM.

C) Was the corner restored through acceptance of (1) an obliterated evidence location, or, (2) a found perpetuated location?

ACCEPTED FD ALUM. MON.

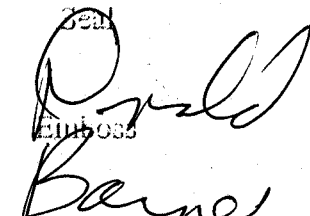
D) Describe any material discrepancy between the location of the corner as restored or reestablished and the location of that corner as previously restored or reestablished by distance and direction. Show the discrepancy on the plan view drawing under (a), above. Show the distances between the corner as previously restored or reestablished and (1) the corner as restored or reestablished, and (2) to at least 4 of the witness monuments shown on the drawing in (a), above.

NONE

(E) Was the corner reestablished through lost corner proportionate methods? If so, show the method, including the directions and distances to other public land survey corners used as evidence or used for proportioning the corner location.

NO

I, Donald Barnes, hereby certify that the corner location as identified by the corner code index was determined by me under my direction and control and that this U.S. Public Land Survey Monument Record is correct and complete to the best of my knowledge and belief.


 Donald Barnes
 3-18-2009

SHEET 1 OF 2

CORNER CODE G-9(1)

A.E. 7.08 REQUIREMENT

