

Paper weight-110# (minimum)

Black nonfading ink required

U.S. PUBLIC LAND SURVEY MONUMENT RECORD

For Public Land Survey Corners In:

WI ADMINISTRATIVE CODE A-E 7.08 REQUIREMENT

T. 4 N. R. 11 E. 4th P.M.

REV 10/23/2004

USMONREC.DWG

CORNER CODE INDEX

| | | | | | | | | | | | | | | | | | | | | | | | | | | | |
|---|---|---|---|---|---|---|---|---|---|----|----|----|----|----|----|----|----|----|----|----|----|----|----|----|----|--|---|
| | 1 | 2 | 3 | 4 | 5 | 6 | 7 | 8 | 9 | 10 | 11 | 12 | 13 | 14 | 15 | 16 | 17 | 18 | 19 | 20 | 21 | 22 | 23 | 24 | 25 | | |
| A | | | | | | | | | | | | | | | | | | | | | | | | | | | A |
| B | | | | | | | | | | | | | | | | | | | | | | | | | | | B |
| C | | | | | | | | | | | | | | | | | | | | | | | | | | | C |
| D | | | | | | | | | | | | | | | | | | | | | | | | | | | D |
| E | | | | | | | | | | | | | | | | | | | | | | | | | | | E |
| F | | | | | | | | | | | | | | | | | | | | | | | | | | | F |
| G | | | | | | | | | | | | | | | | | | | | | | | | | | | G |
| H | | | | | | | | | | | | | | | | | | | | | | | | | | | H |
| J | | | | | | | | | | | | | | | | | | | | | | | | | | | J |
| K | | | | | | | | | | | | | | | | | | | | | | | | | | | K |
| L | | | | | | | | | | | | | | | | | | | | | | | | | | | L |
| M | | | | | | | | | | | | | | | | | | | | | | | | | | | M |
| N | | | | | | | | | | | | | | | | | | | | | | | | | | | N |
| O | | | | | | | | | | | | | | | | | | | | | | | | | | | O |
| P | | | | | | | | | | | | | | | | | | | | | | | | | | | P |
| Q | | | | | | | | | | | | | | | | | | | | | | | | | | | Q |
| R | | | | | | | | | | | | | | | | | | | | | | | | | | | R |
| S | | | | | | | | | | | | | | | | | | | | | | | | | | | S |
| T | | | | | | | | | | | | | | | | | | | | | | | | | | | T |
| U | | | | | | | | | | | | | | | | | | | | | | | | | | | U |
| V | | | | | | | | | | | | | | | | | | | | | | | | | | | V |
| W | | | | | | | | | | | | | | | | | | | | | | | | | | | W |
| X | | | | | | | | | | | | | | | | | | | | | | | | | | | X |
| Y | | | | | | | | | | | | | | | | | | | | | | | | | | | Y |
| Z | | | | | | | | | | | | | | | | | | | | | | | | | | | Z |
| | 1 | 2 | 3 | 4 | 5 | 6 | 7 | 8 | 9 | 10 | 11 | 12 | 13 | 14 | 15 | 16 | 17 | 18 | 19 | 20 | 21 | 22 | 23 | 24 | 25 | | |

PORTER TWP

ROCK COUNTY WI

IF AVAILABLE
ROCK COUNTY COORDINATES PREFERRED

North _____ Elev. _____

East _____

Hor. Datum _____ Vert. Datum _____

LATITUDE _____ ELLIPS. HT. _____

LONGITUDE _____

NAD83(91) _____ NETWORK ADJ. YR _____

GPS (X) _____ TRAVERSE (X) _____

BASED ON THE FOLLOWING CONTROL:

PLACE MONUMENT SYMBOL AT PROPER LOCATION ON ABOVE INDEX

CORNER MONUMENT

WITNESS MONUMENT

BEARINGS ARE BASED ON: _____

FIELD BOOK _____ PAGE # _____

SHEET 1 OF 3

SHOW A PLAN VIEW DRAWING DEPICTING THE CORNER MONUMENT AND SURROUNDING PHYSICAL FEATURES, INCLUDING THE EXCAVATION AREA AND DEPTH.

PLANNING & ZONING COMMITTEE ADOPTED THIS FORM ON 12/2/1982

CORNER CODE R-3(1)

P0582

S 1/4 COR SEC 19

(B) Describe any record evidence, monument evidence, occupational evidence, testimonial evidence or any other material evidence you considered, and whether the monument was found or placed.

- 1833 (NOV) HARRISON T4N R11E 4TH MER. WEST BET SECS 19 & 30
 2640.0 QUARTER SEC COR. {BURR O 12 S3W 35.64' ; BURR OAK 18 NORTH 73.26' {BURR O 12; BURR O 18} MARKED
 5181.00 INT. W. BDY 39.60' NORTH OF POST {BURR OAK 10 S82E 52.8'; BURR O 18 N62E 81.18' {BURR OAK 10; BURR OAK 18} MARKED LAND @ ? SAME.
- 1848 STEBBINS PORTER TWP RD REC BK 1 PG 3 BEGINNING AT THE 1/4 POST OF THE SOUTH LINE OF SEC 18 T4N R11E EAST; THENCE SOUTH ON THE 1/4 LINE OF SEC 19 5280' TO THE 1/4 POST ON THE NORTH LINE OF SEC 30; THENCE SOUTH ON THE 1/4 LINE OF SEC 30 5280' TO THE 1/4 POST ON THE SOUTH LINE OF SEC 30; THENCE SOUTH ON THE 1/4 LINE OF SEC 31 990' TO THE CENTER OF THE RD LEADING FROM JANESVILLE TO MADISON. THE WHOLE LENGTH OF THE RD IS 11,550. VARIATION OF NEEDLE 7 3/4 HARRISON STEBBINS CO. SURVEYOR.
- 1868 LOCKE VOL 1 PG 329 & 3607 FOUND STUMP OF BTS SET BURR OAK STAKE WITH BLUEHARD HEAD ON N. AND BROWN HARDHEAD ON S. USED TO SUBDIVIDE SEC 19
- 1874 RUGER VOL 2 PG 179 FD COR SET BY LOCK, DROVE NEW STAKE IN PLACE OF OLD ONE. PUT LIMESTONE ON SOUTH & HH ON N OF STAKE, 2548.26 TO NW COR SEC 30
- 1899 BROWN VOL 2 PG 510 FD STAKE WITH LIMESTONE ON S & HH ON N. SET IRON .
- 1903 PORTER TWP RD REC BK 3 PG 13 BEGINNING ON THE NORTH AND SOUTH QUARTER SECTION LINE RUNNING NORTH AND SOUTH THROUGH SEC 31, T4N R11E, ROCK COUNTY AT A POINT WHERE THE PUBLIC HIGHWAY NOW RUNNING NORTH AND SOUTH THROUGH THE CENTER OF SECTION 7, 18,19,30, AND A PART OF 31 IN SAID T4 INTERSECTS THE PUBLIC HIGHWAY RUNNING FROM EVANSVILLE TO JANESVILLE AND KNOWN AS THE MADISON ROAD AND RUN THENCE DUE SOUTH ALONG THE QUARTER SEC LINE THROUGH SAID SEC 31 IN SAID T4 TO THE SOUTH LINE OF SAID SEC 31. SAID PROPOSED HIGHWAY CROSSING LAND OWNED BY W.B. VAN WART, D.C. & ED GRIFFITH, JACOB BENKERT, JACOB ELMEN AND THE CHICAGO & NORTHWESTERN RAILWAY COM.

AFTERWARDS UPON APPEAL TAKEN BY FRANK MONTGOMERY FROM THE DETERMINATION SO REFUSING TO LAY OUT SUCH HIGHWAY AS AFORESAID, COMMISSIONERS WERE DULY APPOINTED TO REVIEW THE SAID DETERMINATION AND SUCH PROCEEDINGS WERE DULY HAD BEFORE THEM THAT THE SAME WAS FINALLY REVERSED AS APPEARS BY THEIR DECISION BEGINNING ON THE NORTH AND SOUTH QUARTER SEC LINE RUNNING NORTH & SOUTH THROUGH SEC 31, T4N R11E AT A POINT WHERE THE PUBLIC HIGHWAY NOW RUNNING NORTH AND SOUTH THROUGH THE CENTER OF SEC 7-18-19-30 AND A PART OF 31 IN SAID T4 INTERSECTS THE PUBLIC HIGHWAY RUNNING DUE SOUTH ON QUARTER LINE TO WITHIN 165' OF LAND OWNED BY CHICAGO & NORTHWESTERN RAILROAD CO. CROSSES SAID 1/4 LINE; THENCE SOUTH EAST TO LAND OWNED BY CHICAGO & NORTHWESTERN RAILROAD TO A POINT 164' EAST OF RAILROAD BRIDGE NOW ON SAID QUARTER LINE; THENCE SOUTH ACROSS LAND OWNED BY CHICAGO & NORTHWESTERN RAILROAD CO. AS NEAR AS PRACTICABLE;

Donald Barnes
 6-12-09

SHEET 1 OF 3
 CORNER CODE R-3(1)

PO582 S1/4CORSEC19

THENCE SOUTH WEST TO A POINT WHERE SAID QUARTER LINE INTERSECTS THE SOUTH LINE OF SAID SEC 31 SAID LINE IS THE CENTER OF SAID HIGHWAY AND THE SAME IS LAID OUT OF THE WIDTH OF 66'. E.M. STEBBINS TOWN CLERK.

- 1957 BATTERMAN VOL 3 PG 519 DUG 15X6X4 DEEP HOLE FD 1" IRON BOLT WITH NUT SMALL HH N & SMALL SS S. SET 1 1/2 PIPE ABOVE BOLT. REFERENCED SAME. SHOWS ON LINE WITH E/W FENCE LINE IN CENTER OF RD. 2671.85 TO GEN OF SEC 19 & 5346.28 TO N 1/4 COR SEC 19. [PENGELED NOTE: REFERENCED SEE PAGE 439 VOL 4]
- 1970 BATTERMAN VOL 4 PG 439 SET MON BOX OVER 1" PIPE & REFERENCED SAME. CENTER OF SEC 30 IS ALSO REFERENCED.
- 1970 THOM GSM VOL 2 PG 3 FD MON. SOUTH 2668.60 TO IP @ CENTER OF SEC 30
- 1971 THOM 2668.60 TO CENTER OF SEC 30
- 1971 LEE VOL 4 PG 493 FD MON BOX OVER 1" PIPE. REFERENCED SAME. ON LINE WITH E/W FENCE LINE REREFERENCED GEN OF SEC 30
- 1976 BARNES VOL 5 PG 177 FD PIPE IN MON BOX 2668.87 TO CENTER OF SEC 30.
- 1985 BARNES VOL 6 PG 346 NO-04-39E 2671.88 TO CENTER OF SEC 19
- 1985 BARNES R-3 FD 1 1/2 PIPE IN MON BOX. REFEERENCED SAME. 3' EAST OF PVMT CENTER. ON LINE WITH E/W FENCE LINES.
- 1986 BARNES VOL 6 PG 360 FD 1 1/2 PIPE IN MON. BOX NO-04-39E 2671.88 ALUM MON @ GEN SEC 19, 5346.49 TO N 1/4 COR SEC 19
- 1994 KARNES GSM VOL 17 PG 148 FD ROCK COUNTY ALUM. MON NORTH TO N 1/4 COR SEC 19
- 1995 KARNES GSM VOL 18 PG 190 FD ROCK COUNTY ALUM. MON 5346.99 TO N 1/4 COR SEC 19
- 1998 KARNES GSM VOL 21 PG 350 ROCK COUNTY MON. N00-04-52W TO N 1/4 COR SEC 19

FD 1 1/2" PIPE IN MON BOX; TOP OF BOX IS 0.3' BELOW PVMT; 2.0 EAST OF GEN. OF PVMT.; MON IS ON LINE WITH E/W FENCES.

C) Was the corner restored through acceptance of (1) an obliterated evidence location, or, (2) a found perpetuated location?

ACCEPTED PERPETUATED CORNER. PERPETUATES RUGER'S POSITION.

D) Describe any material discrepancy between the location of the corner as restored or reestablished and the location of that corner as previously restored or reestablished by distance and direction. Show the discrepancy on the plan view drawing under (a), above. Show the distances between the corner as previously restored or reestablished and (1) the corner as restored or reestablished, and (2) to at least 4 of the witness monuments shown on the drawing in (a), above.

NONE

(E) Was the corner reestablished through lost corner proportionate methods? If so, show the method, including the directions and distances to other public land survey corners used as evidence or used for proportioning the corner location.

NO

I, **Donald Barnes**, hereby certify that the corner location as identified by the corner code index was determined by me under my direction and control and that this U.S. Public Land Survey Monument Record is correct and complete to the best of my knowledge and belief.



Seal

Embloss


SHEET 2 OF 3

CORNER CODE **R-3(1)**

6-12-09 A.E. 7.08 REQUIREMENT

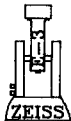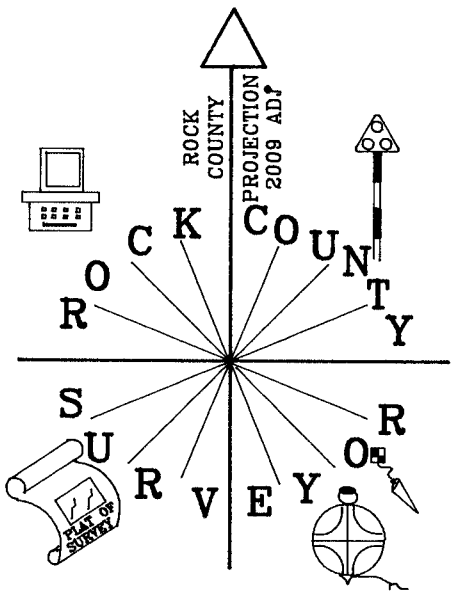

TOLLES RD

NOT TO SCALE

STA 788
COTTON GIN PIN
2' EAST OF
WEST PVMT EDGE

S 1/4 COR
SEC 19
PORTER TWP
T4N R11E

FD BENT PIPE
REPLACED WITH
3/4X24 RERDD

1985 BARNES R-3
FB#2 PG 45

1971 LEE VOL 4 PG 493
REF MONUMENTS ARE 1" PIPES

1970 BATTERMAN VOL 4 PG 439
SET MON BOX OVER

REF MONUMENTS ARE 1" PIPES

1957 BATTERMAN VOL 3 P G 519
REF. MONUMENTS ARE 1-1/2"

+ SEARCHED &
FD NOTHING

■ SQ CONC
FENCE POST

□ FD 1 1/2 PIPE
IN MON BOX
TOP OF BOX IS
0.3' BELOW PVMT,
2.0' EAST OF
CEN. PVMT.

FD BENT PIPE
REPLACED WITH
3/4X24 RERDD

1971 CONC. FENCE
POST- 33.54

1970 CONC FENCE
POST 33

1957 CONC FENCE
POST 34.77

CONC. FENCE
POST-1971

FD PIPE

FD PIPE

XXXXXXXXXXXXXXXXXXXX

18" BOX
ELDER

1957 CONC FENCE
POST 30.69

6" BOX
ELDER

EMBOSSED
SEAL

Dwight Barnes
6-11-09

SHEET 3 OF 3

R-3(1)

FD 3/8 PIN

FD BENT
RERDD
NEW UP

