

# PLAT AND RECORD

Of a Survey on Section 10 T 2 R 11 E. of the 4 P. M. in Plymouth Township


Rock County, Wisconsin, made June the 4<sup>th</sup> 1855

I hereby certify that the following is a correct record of said survey as made by me.

COUNTY BUILDING  
IN CITY OF BELOIT

(Signed) Joseph Church  
JAC

County Surveyor.

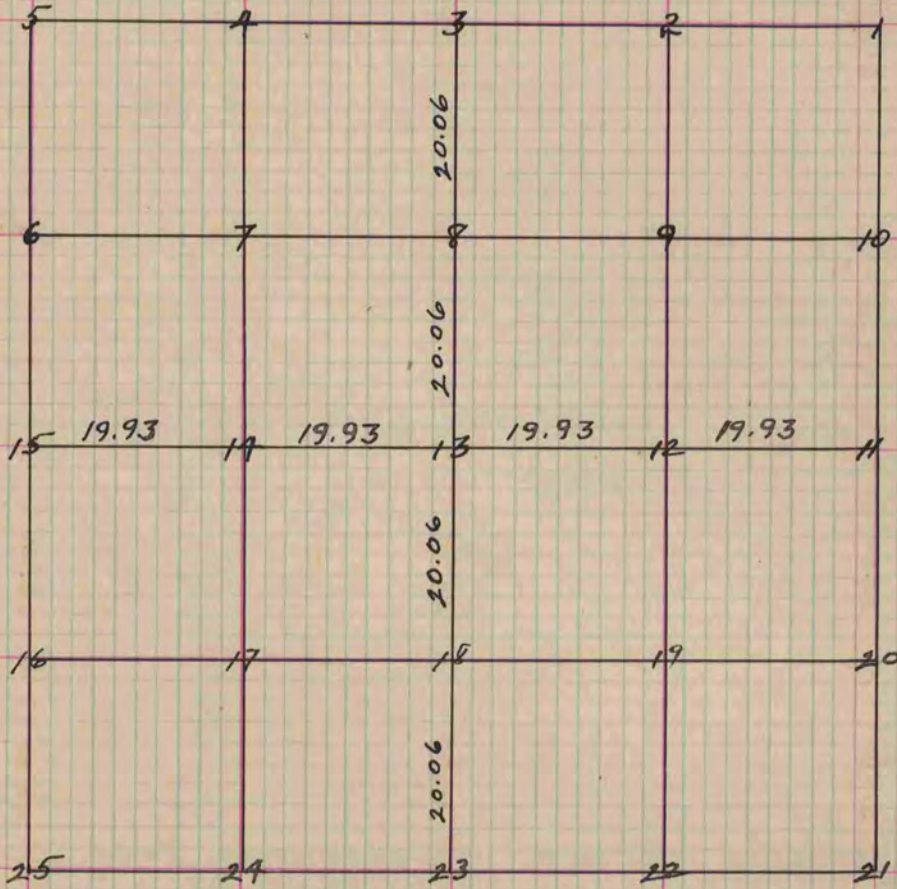

- Fig. 15 W.O. 24 S. 63 W. 270 links.  
Bur.O. 20 S. 85 E. 163 "
- " 13 Stake no bearings.
- " 10 " " "
- " 8 " " "

Copied from Page 41. Vol. 1 Original County Surveyors Record.