

PLAT AND RECORD

Of a Survey on Section 1 T 4 R 14 E. of the 4 P. M. in Lima Township


Rock County, Wisconsin, made April the 14th 1857

I hereby certify that the following is a correct record of said survey as made by me.

COUNTY BUILDING
IN CITY OF BELOIT

(Signed) Joseph Church
JACB

County Surveyor.

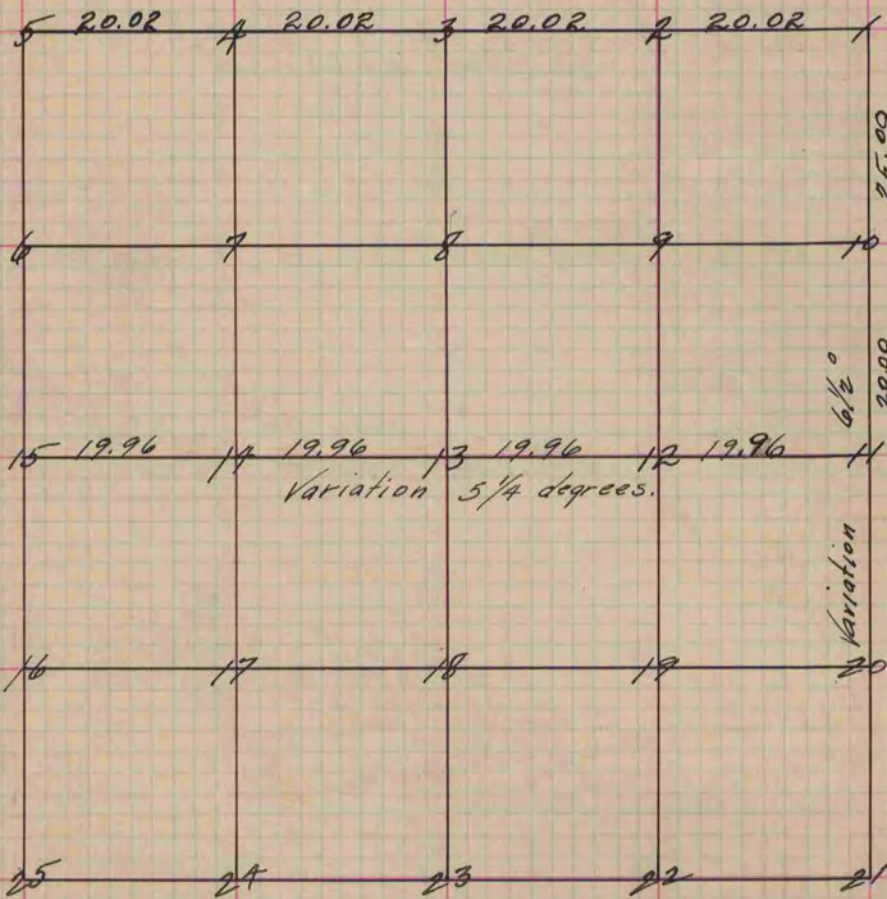

- Fig. 13 Stake in the Marsh.
- " 8 " " " "
- " 10 Maple 2561 W. 42 1/2
- " " 2" 30 W. 75 links
- " 11 One of the trees cut bearings.

Copied from Page 75 Vol. 1. Original County Surveyor's Record