

# PLAT AND RECORD

Of a Survey on Section 35 T 3 R 10 E. of the 4 P. M. in Magnolia Township

Rock County, Wisconsin, made September the 2<sup>nd</sup> 1858

I hereby certify that the following is a correct record of said survey as made by me.

COUNTY BUILDING  
IN CITY OF BELOIT

(Signed) Joseph Church  
R. N. Balthasar County Surveyor.

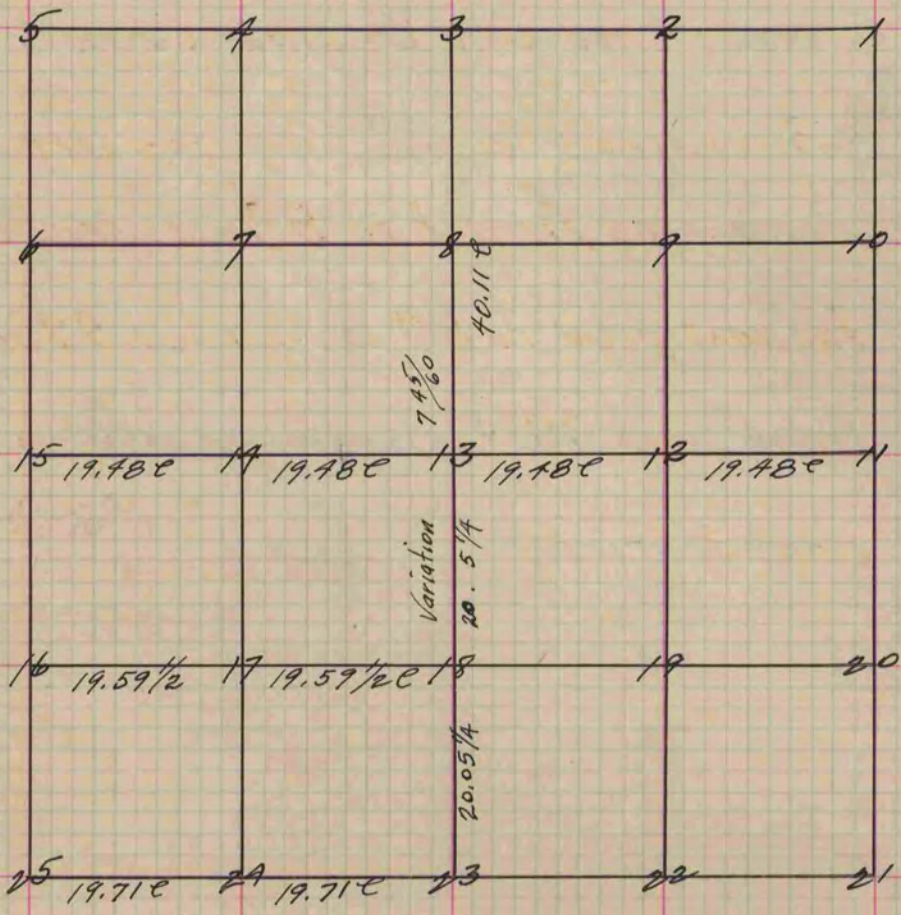


Fig. 13 Stake on the Prairie no bearings.  
 " 18 " " " " " " "  
 " 17 " " " " " " "  
 " 24 " " " " " " "

Copied from Page 85 Vol. Original County Surveyor's Record.