


## PLAT AND RECORD

Of a Survey on Section 14 T 2 R 11 E. of the 4 P. M. in Plymouth Township  
 Rock County, Wisconsin, made April the 23<sup>rd</sup> & 24<sup>th</sup> 1856

I hereby certify that the following is a correct record of said survey as made by me.

COUNTY BUILDING  
 IN CITY OF BELOIT

(Signed) Joseph Church  
RAB County Surveyor.

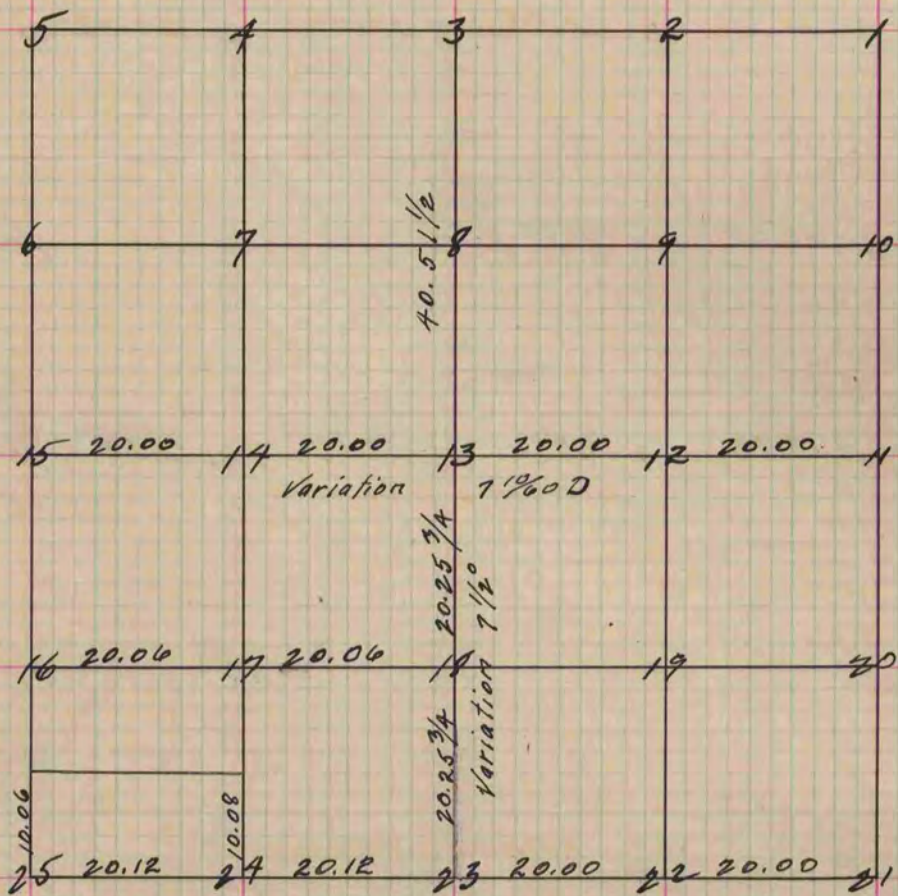

- Fig. 13 Stone hard 15 long 9 thick & 9 wide  
 Wit. to stone W.O. 30 S. 4 1/2 E 215 links. Variation 7 1/2°
- " 23 Found stumps corresponding with field notes mostly decayed  
 Took new trees Bl. O. 18 S. 8 1/2 E 80 links.  
 W.O. 30 N. 88° W. 111
- " 12 In the Marsh stone 18 inches long, 10 inches wide & 4 inches thick.
- " 19 Br. O. 24 S. 48 1/4 E. 79 links.
- " 18 Br. O. 12 N. 4 1/4 E. 165 links.  
 Bl. O. 8 N. 40 W. 84 1/2 links.
- " 25 Wit. trees incorrect found stake from the marked bearing.  
 S. 47 W. 180 links & a tree bearing S 29 E. 187  
 Government field notes call for the stake for one tree S 29 E. 107 links.  
 and the other S. 4 W 120 links.

See Page 35

Copied from Page 65 Vol. 1 Original County Surveyors Record.