

# PLAT AND RECORD

Of a Survey on Section 12 T 3 R 10 E. of the 4 P. M. in Magnolia Township


Rock County, Wisconsin, made August the 1855

I hereby certify that the following is a correct record of said survey as made by me.

COUNTY BUILDING  
IN CITY OF БЕЛОIT

(Signed) Joseph Church  
JAC

County Surveyor.

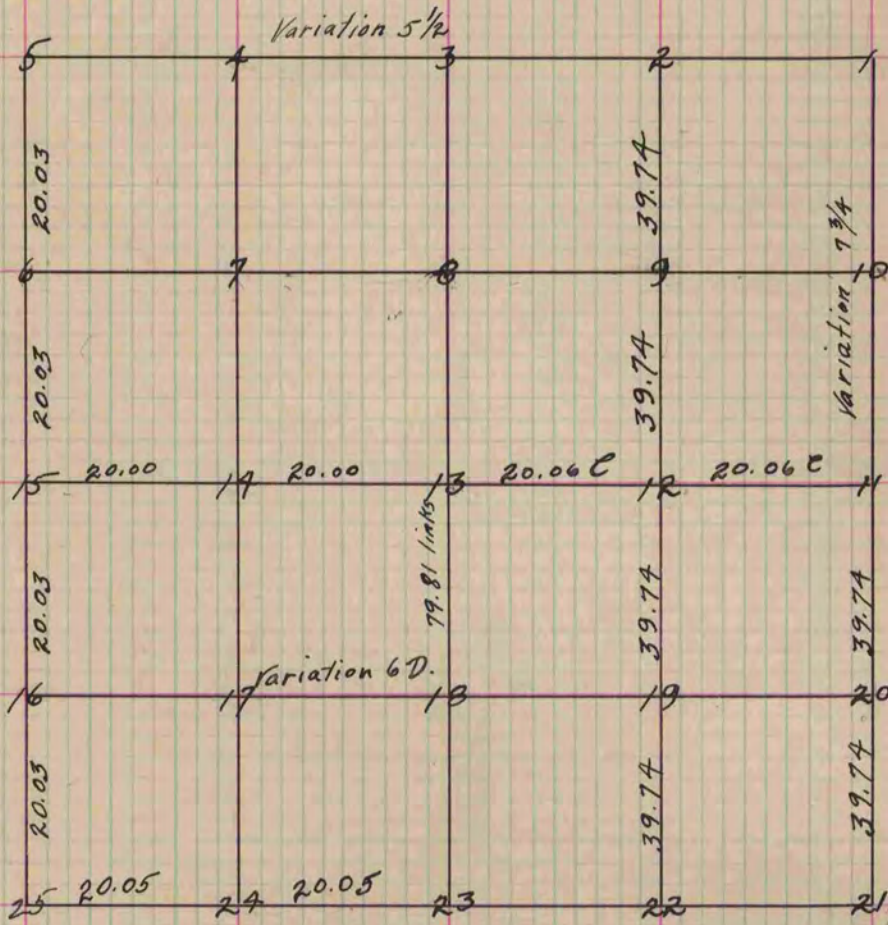

Stakes were driven in the ground at figures, 6-7-8-9 & 10  
No bearings

Copied from Page 49<sup>Vol. 1.</sup> Original County Surveyor's Record<sup>Record</sup>