

PLAT AND RECORD

Of a Survey on Section 27 T 4 R 10 E. of the 4 P. M. in Union Township

Rock County, Wisconsin, made August the 1855

I hereby certify that the following is a correct record of said survey as made by me.

COUNTY BUILDING
IN CITY OF BELOIT

(Signed) Joseph Church
JCH County Surveyor.

Starting Stone of Village of Evansville.

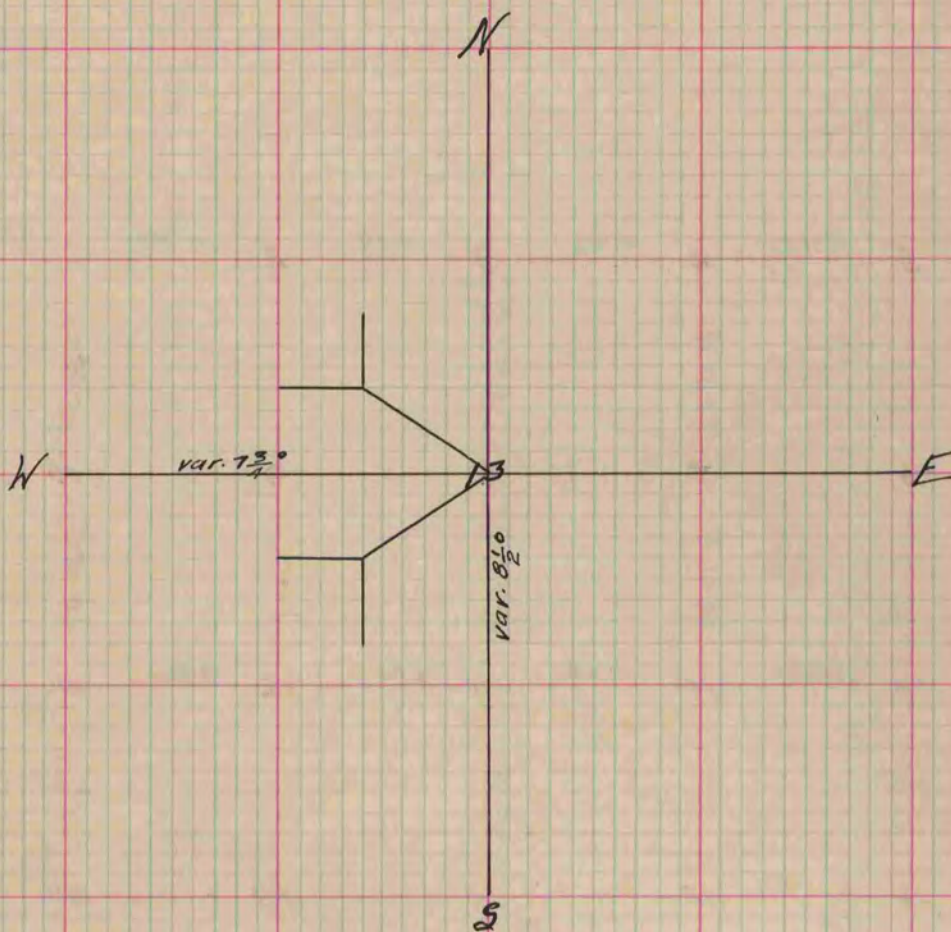


Fig. 13 Spencerhouse N.W. Corner N. $74\frac{1}{2}$ W. 163 links.
 Winston's Store House N.E. Corner S. $57\frac{1}{2}$ W. 153 $\frac{1}{2}$ links.
 Fig. 13 is in the centre of said Section
 The variation was taken without the variation of the Meridian line.

Copied from Page 47 Vol. County Surveyor's Record.