


# PLAT AND RECORD

Of a Survey on Section 28 T 4 R 13 E. of the 4 P. M. in MILTON Township

Rock County, Wisconsin, made NOVEMBER the 10th 1960.

I hereby certify that the following is a correct record of said survey as made by me.

COUNTY BUILDING  
IN CITY OF BELOIT

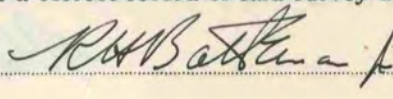

County Surveyor.

THE GEO. D. BARNARD COMPANY, ST. LOUIS

NOTE THIS PAGE WAS IN  
THE JANESVILLE REC DAB, 11/20/75

H. LEE  
T. KERWIN

