

PLAT AND RECORD

COUNTY BUILDING
IN CITY OF BELOIT


Of a Survey on Section 31 T. 1 N., R. 12 E. of the 4 P. M. in BELOIT Township

Rock County, Wisconsin, made MARCH the 11TH 1959

I hereby certify that the following is a correct record of said survey as made by me.

COUNTY BUILDING
IN CITY OF BELOIT

R. B. Egan
County Surveyor.

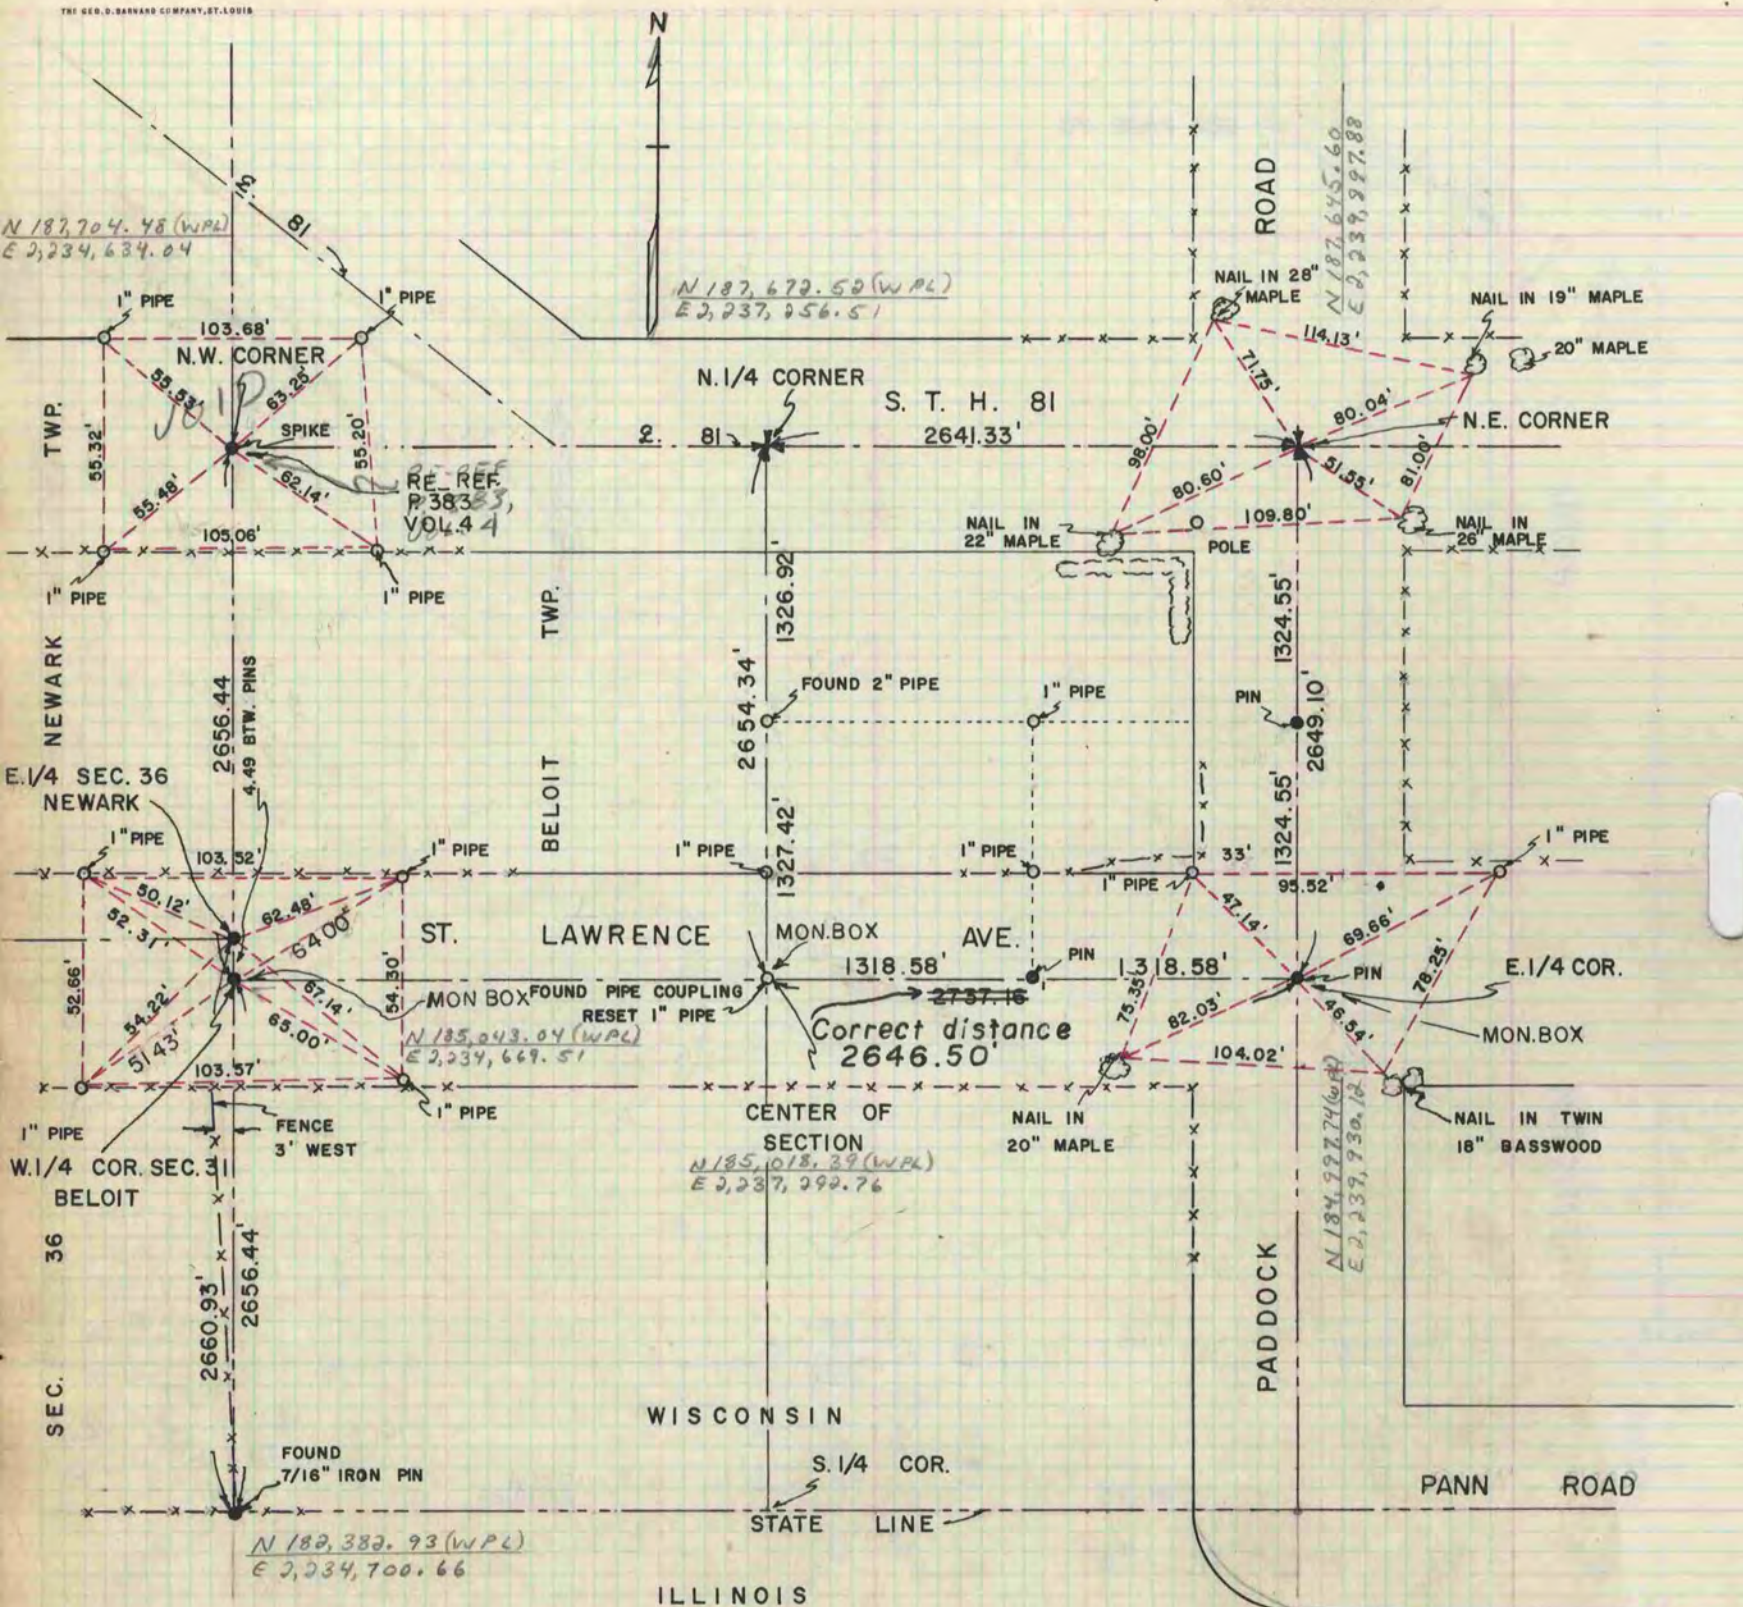

See page 117