

PLAT AND RECORD

93


16-17
 Of a Survey on Section 20-21 T 4 N. R 12 E. of the 4 P. M. in FULTON Township
 Rock County, Wisconsin, made APRIL the 22nd 1961

I hereby certify that the following is a correct record of said survey as made by me.

COUNTY BUILDING
 IN CITY OF БЕЛОIT

Robb H. Egan
 County Surveyor.

NOTE: NOT DRAWN TO SCALE

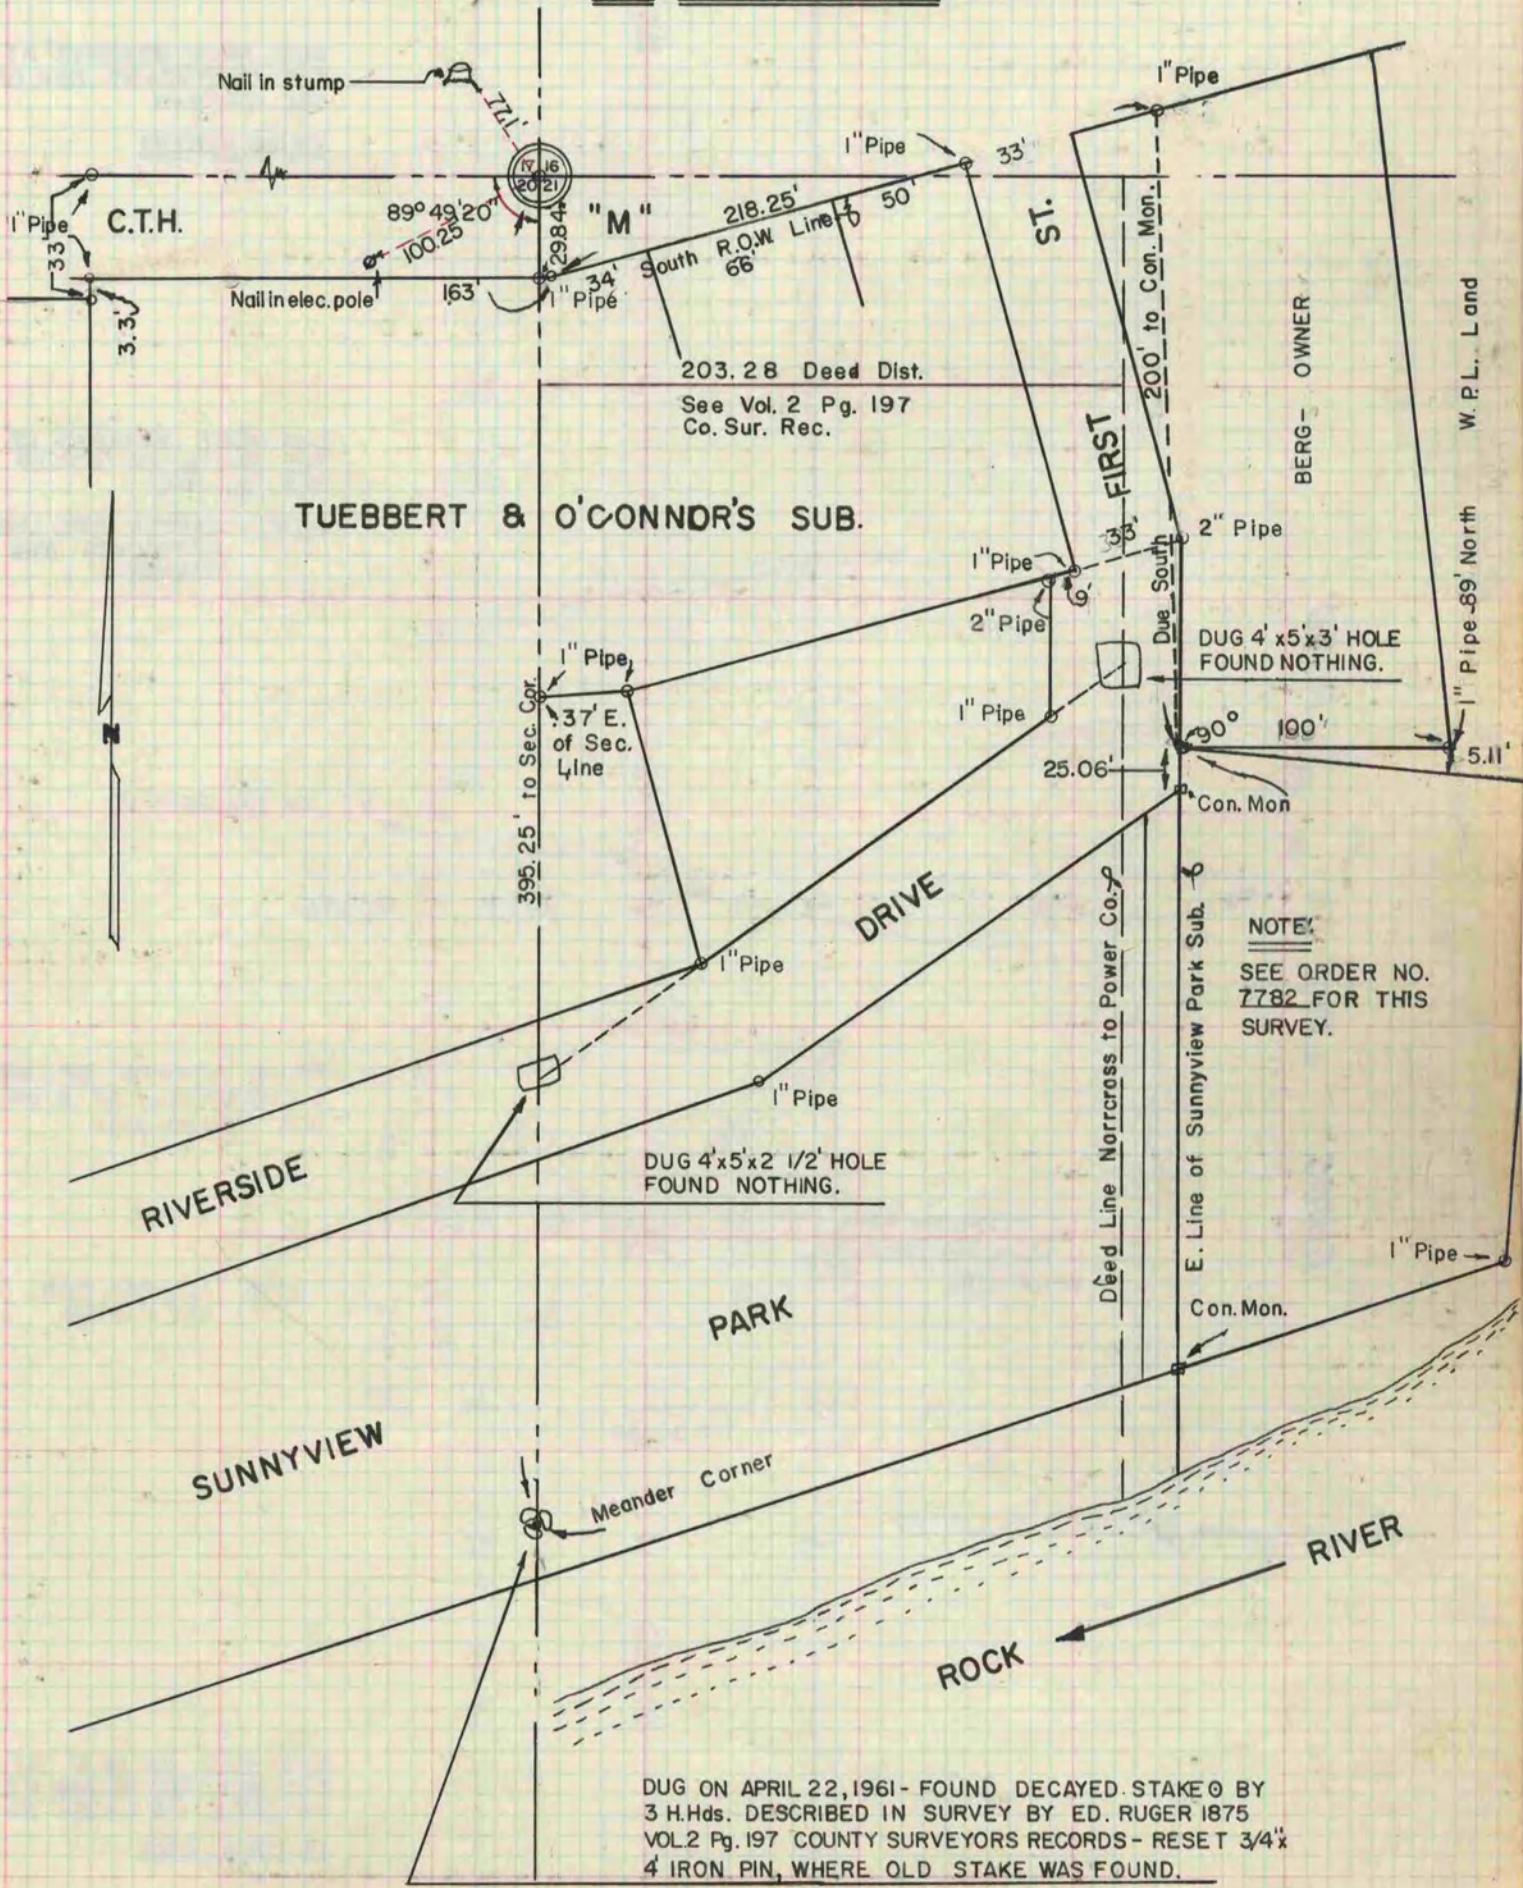

NOTE:
 SEE ORDER NO.
 7782 FOR THIS
 SURVEY.

H. Lee
 T. Kerwin
 J. Kane