


Of a Survey on Section $\frac{26}{33}$ T $\frac{13}{13}$ R $\frac{1}{1}$ E. of the 4 P. M. in TURTLE TURTLE Township

Rock County, Wisconsin, made JUNE the 9TH. 1959

I hereby certify that the following is a correct record of said survey as made by me.

R.A.B. Heman

County Surveyor.

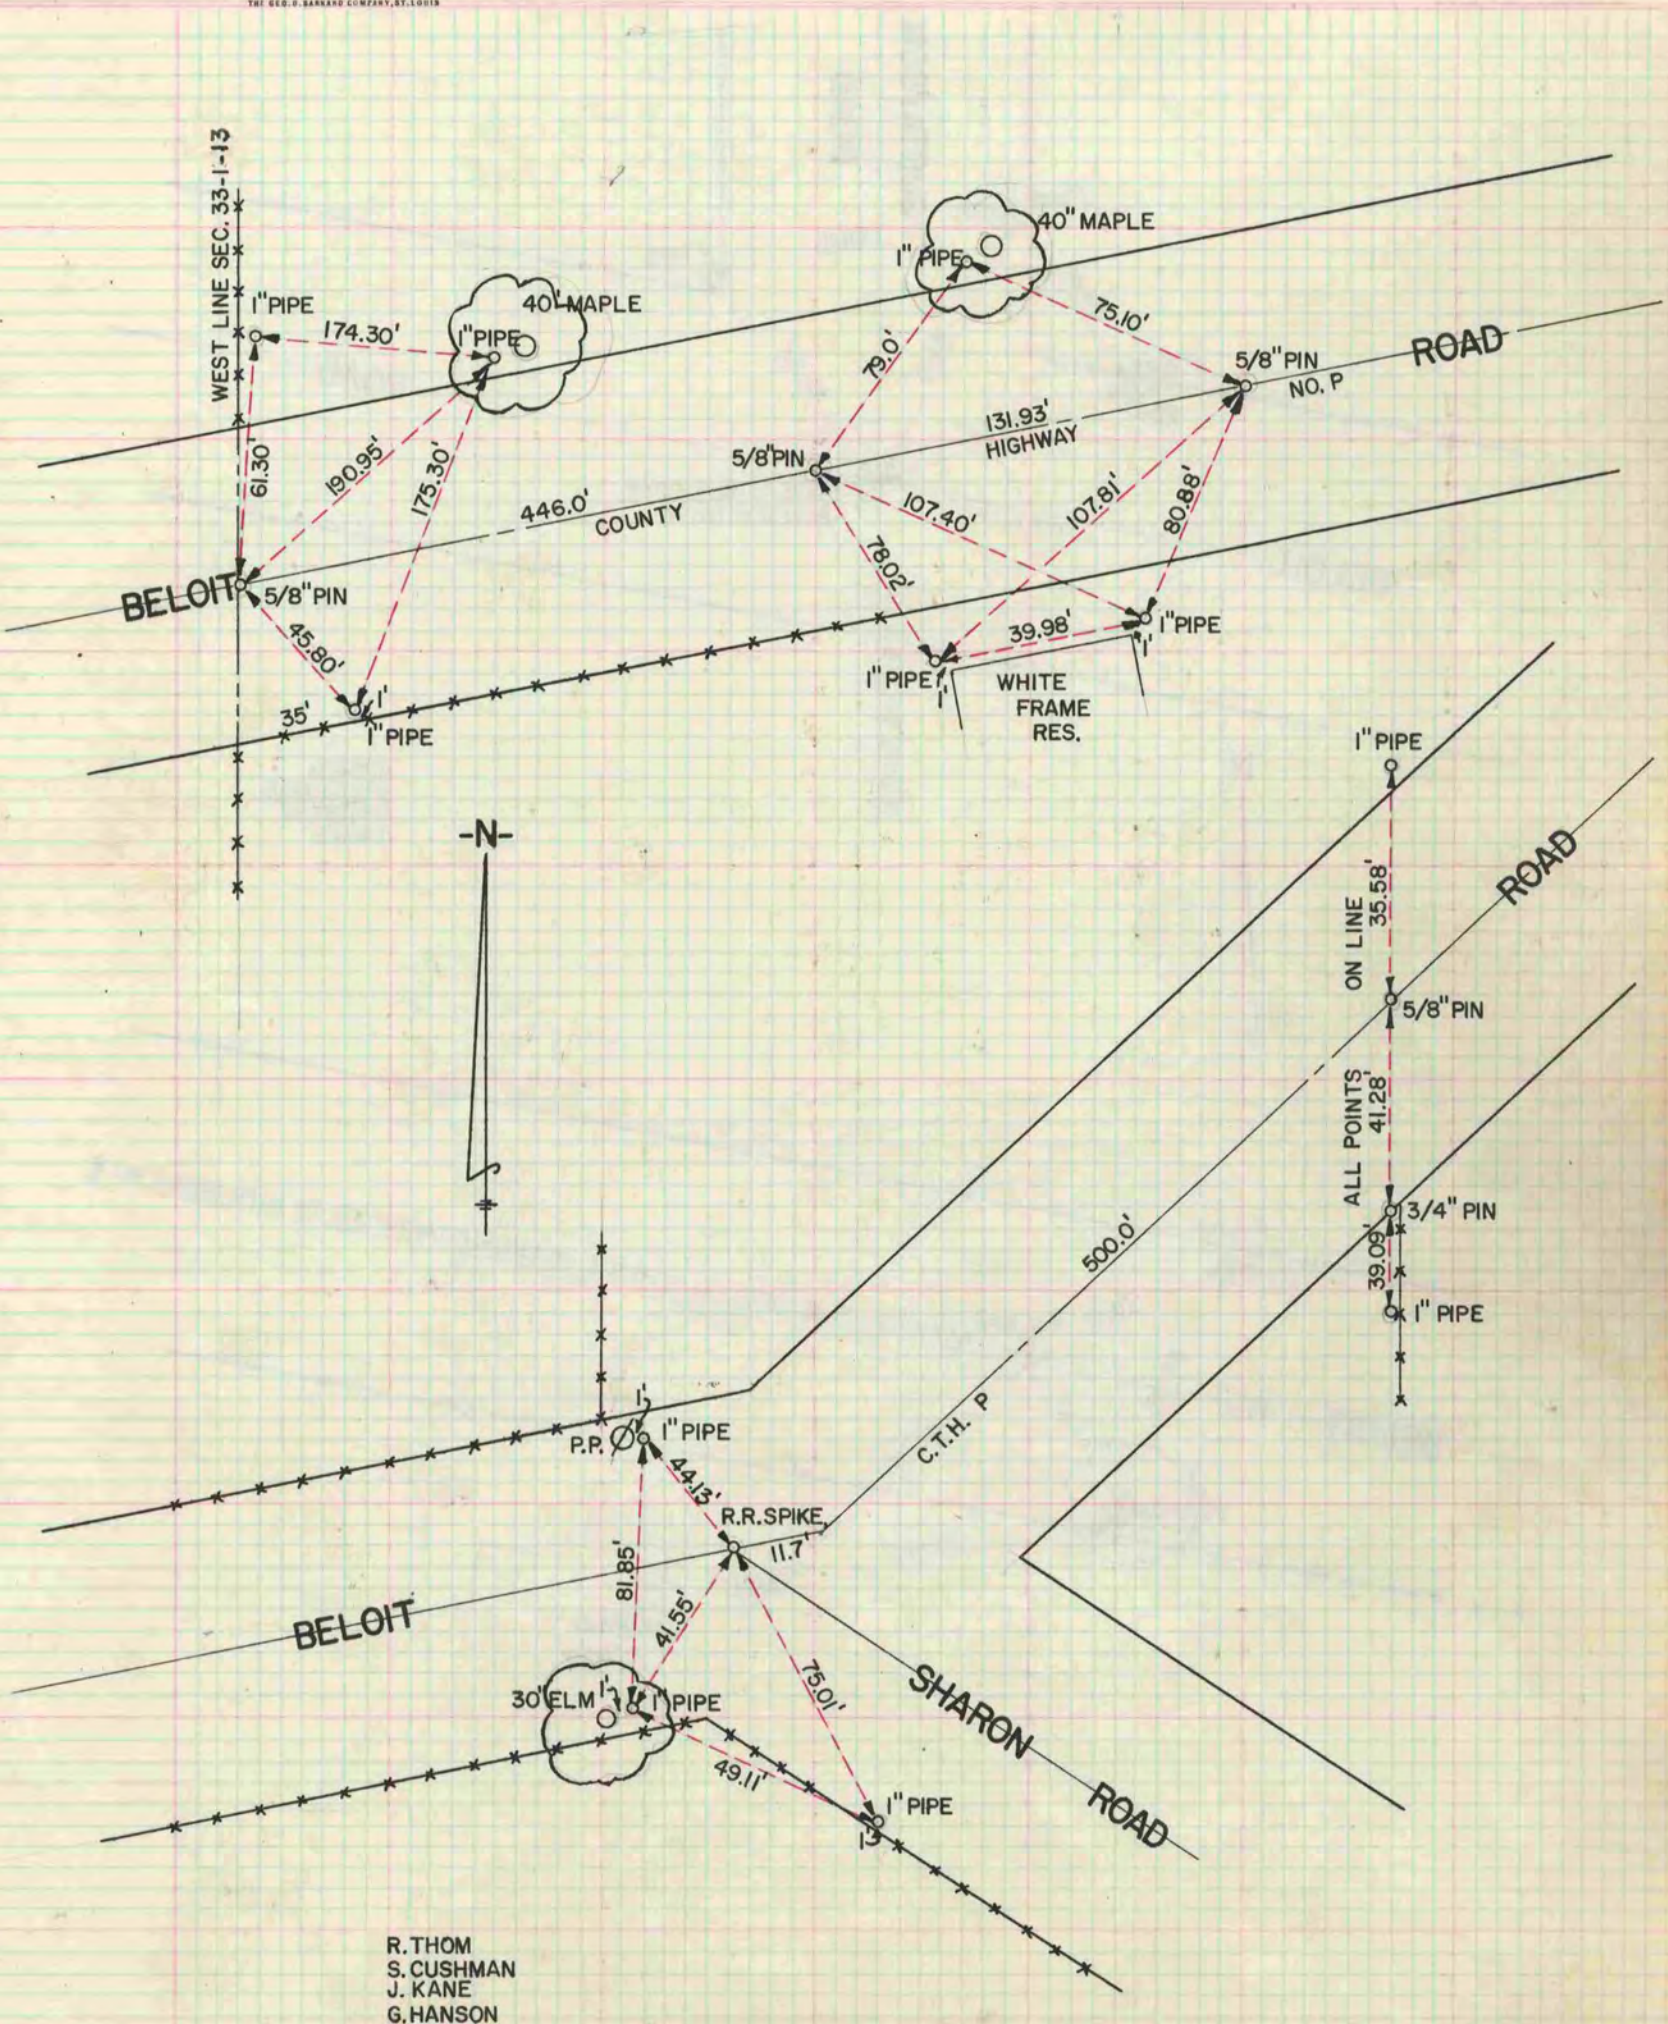

R. THOM
S. CUSHMAN
J. KANE
G. HANSON