

PLAT AND RECORD

Of a Survey on Section 25 T 3 R 11 E. of the 4 P. M. in Centre Township

Rock County, Wisconsin, made June the 16th 1858

I hereby certify that the following is a correct record of said survey as made by me.

COUNTY BUILDING
IN CITY OF BELOIT

(Signed) Joseph Church
JNC

County Surveyor.

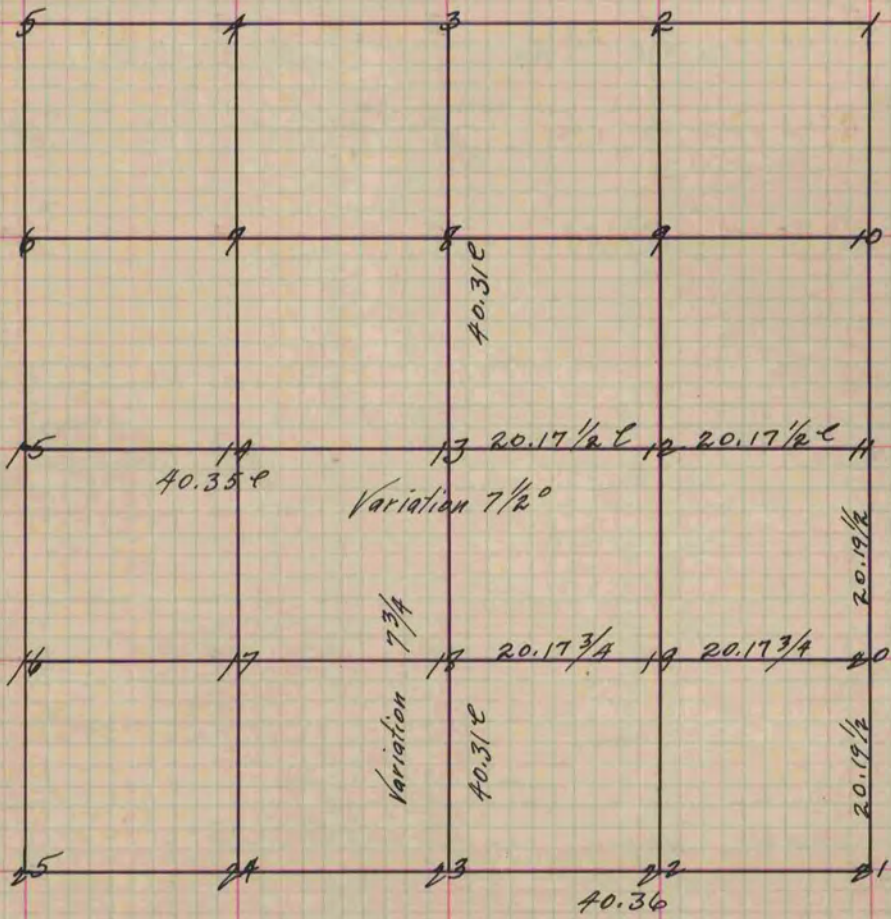


Fig. 12 Stake no bearings.
 " 19 " " " "
 " 20 " " " "
 " 22 Stake in the Centre of Highway No bearings.

Copied from Page 83 Vol. one County Surveyor's Original Record.