

PLAT AND RECORD

Of a Survey on Section 28 T 2 R 10 E. of the 4 P. M. in Spring Valley Township
 Rock County, Wisconsin, made April the 8th & 9th 1855

I hereby certify that the following is a correct record of said survey as made by me.

COUNTY BUILDING
 IN CITY OF БЕЛОIT

(Signed) Joseph Church
 R.H.B.

County Surveyor.

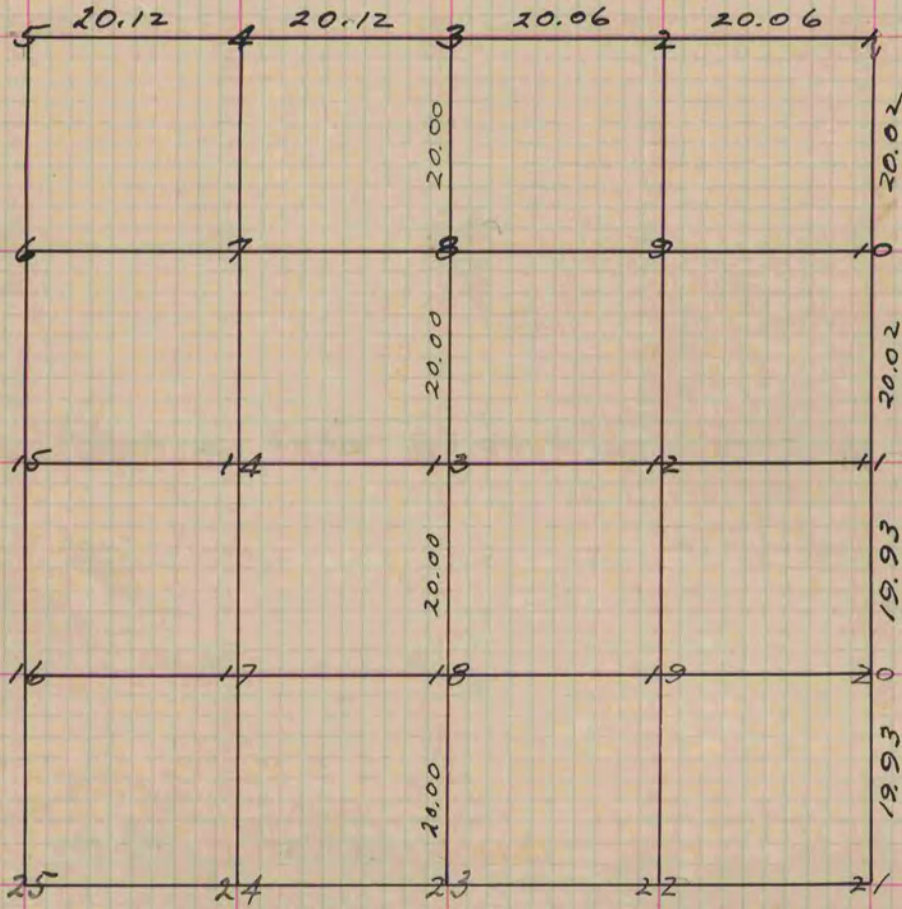


Fig. 13 represents the centre of the Sec.
 Black O. 8 S. 89 1/2 E. 43 links
 Black O. 8 S. 49 1/2 W. 40 "
 " 12 Bur. O. S. 44 W. 18 "
 " 22 W. O. 24 N. 48 1/2 W. 96 "
 " 20 Bur. O. 16 S. 28 1/2 W. 112 "
 " 24 " " N. 59 1/2 E. 24 "
 " 8 " " 16 S. 55 E. 29 "

Copied from page 33 vol. 1. Original County Surveyors Record