

# PLAT AND RECORD

Of a Survey on Section 6 T / R 10 E. of the 4 P. M. in Aron Township


Rock County, Wisconsin, made May the 11<sup>th</sup> & 12<sup>th</sup> 1870

I hereby certify that the following is a correct record of said survey as made by me.

COUNTY BUILDING  
IN CITY OF BELOIT

(Signed) Edward Ruger  
R.H.B.

{Deputy  
County Surveyor.

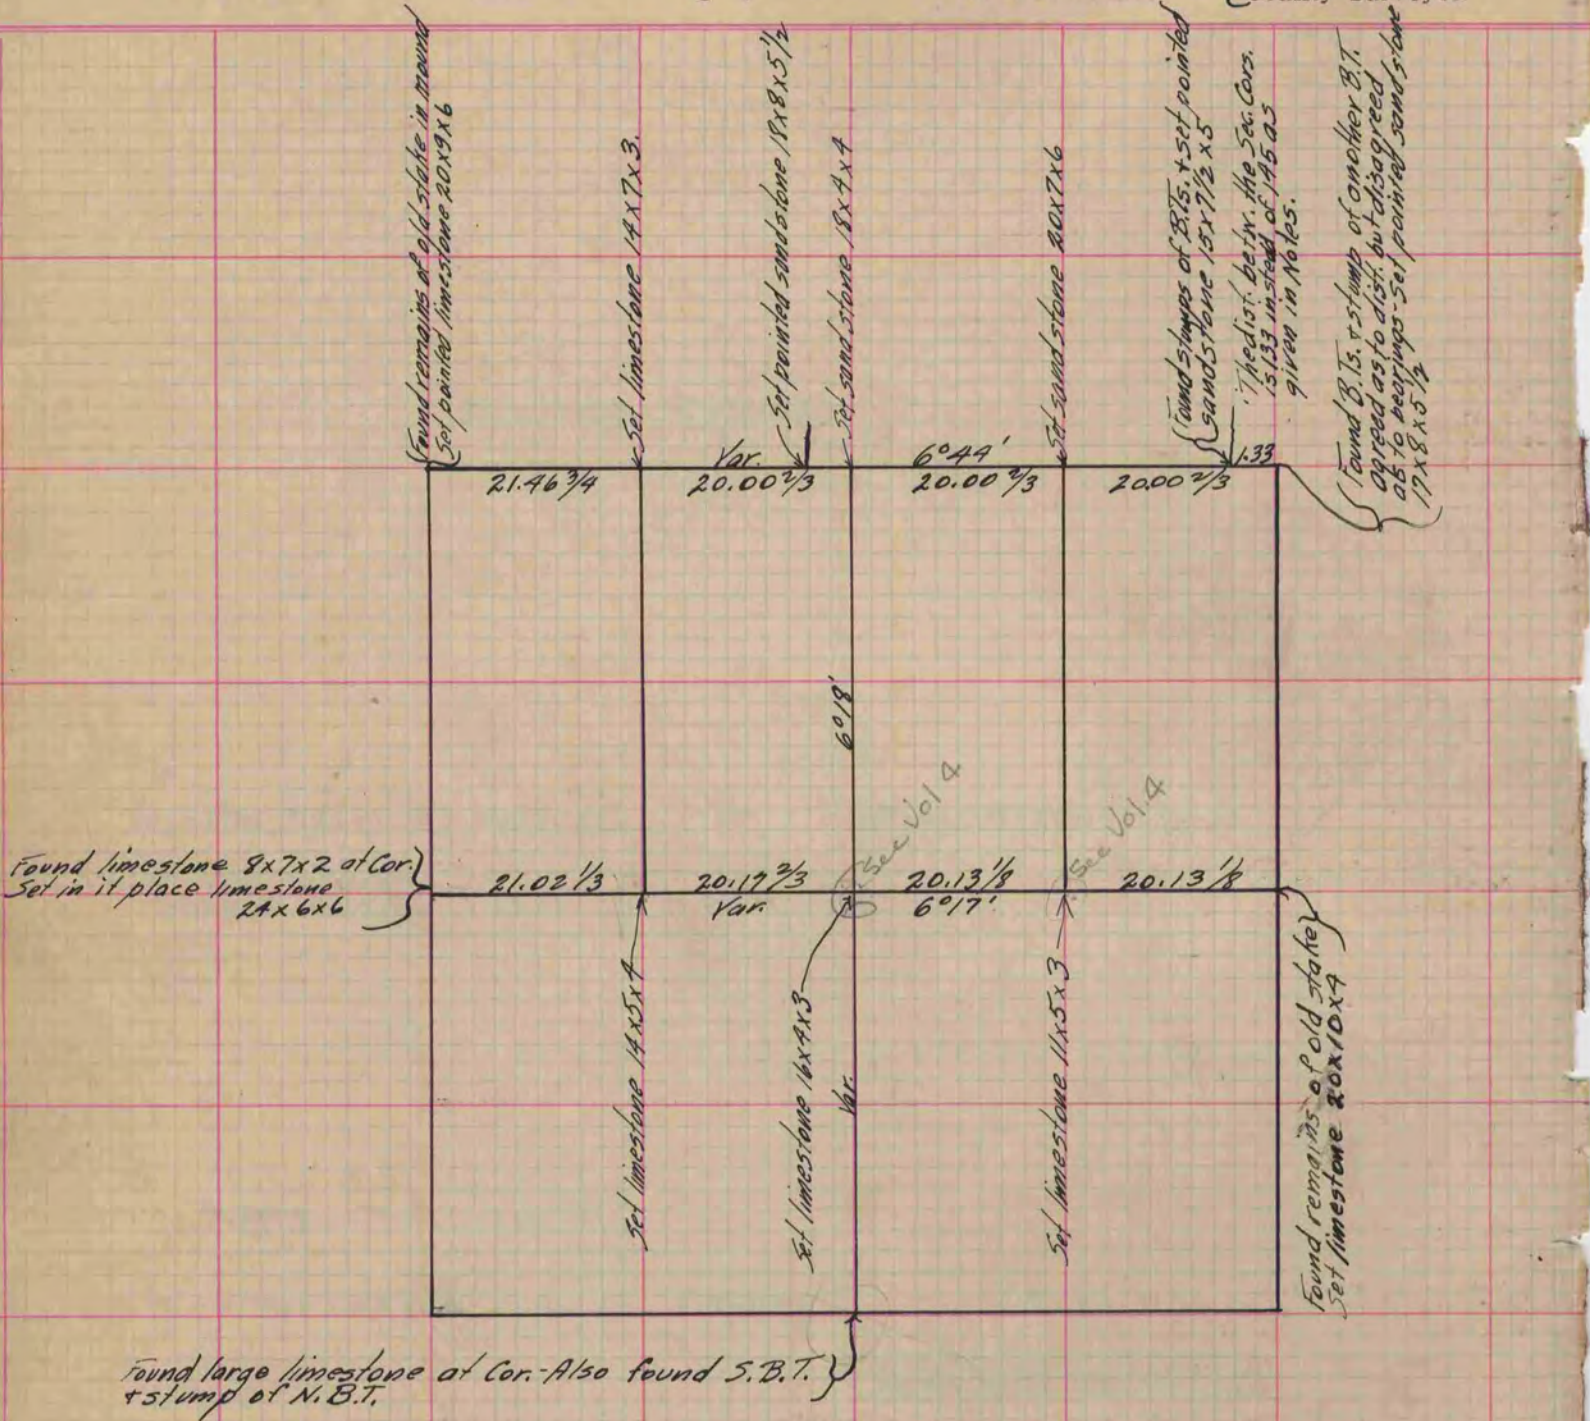

Copied from Page 20 Vol. 2. Original County Surveyor's Record.