

# PLAT AND RECORD


Of a Survey on Section 17 T 2 R 14 E. of the 4 P. M. in Bradford Township  
 Rock County, Wisconsin, made June the 13<sup>th</sup> 1872

I hereby certify that the following is a correct record of said survey as made by me.

COUNTY BUILDING  
 IN CITY OF БЕЛОIT

(Signed) R. K. Lee  
 R.M.B.

(Deputy  
 County Surveyor.

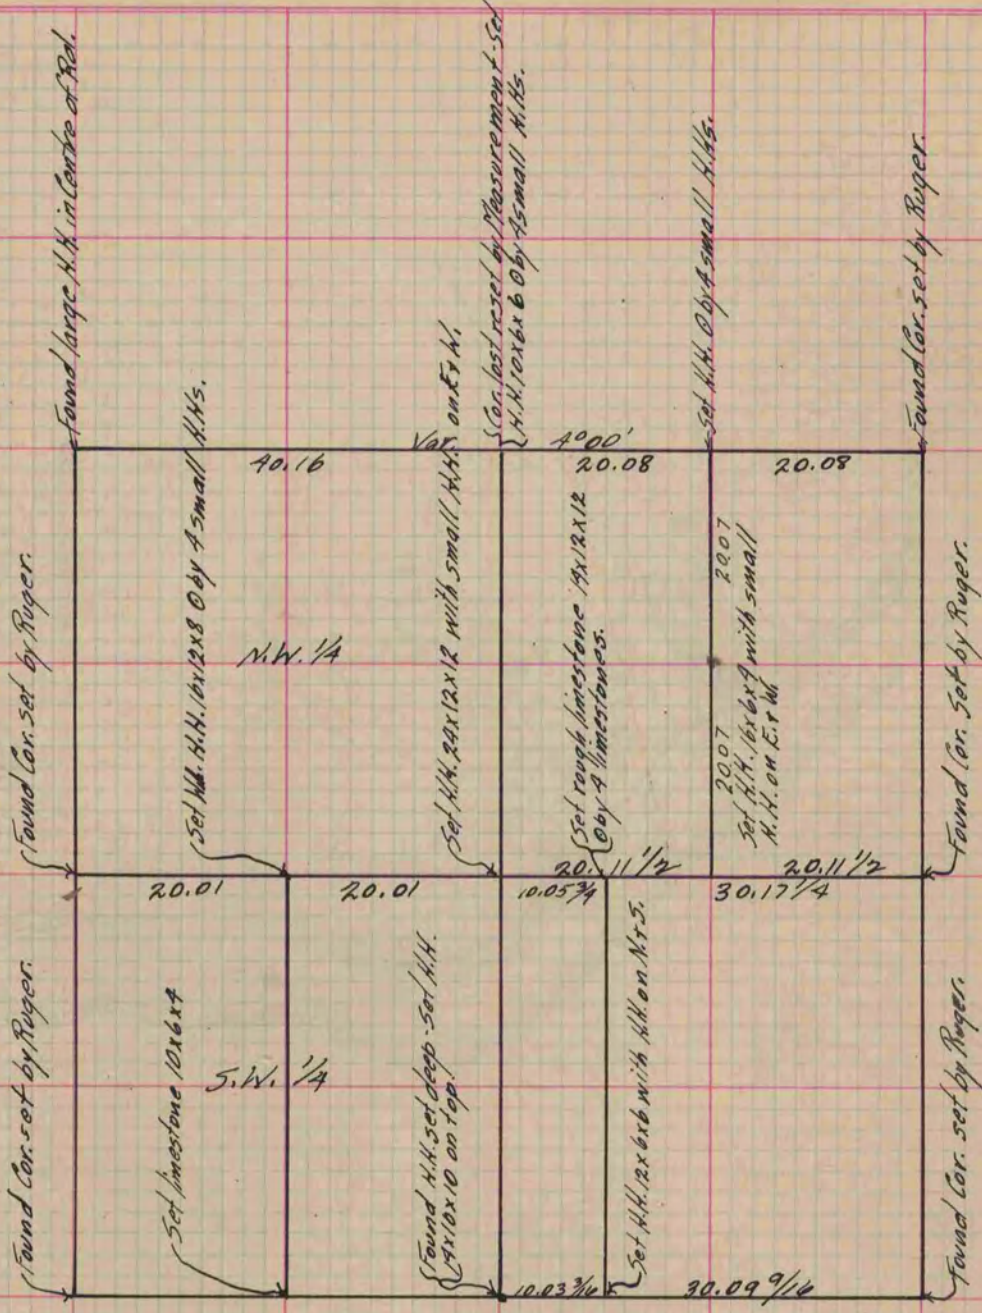

Copied from Page 53 Vol. 2 Original County Surveyor's Record