

PLAT AND RECORD

67


Of a Survey on Section 11 T 2 R 11 E. of the 4 P. M. in Plymouth Township
Rock County, Wisconsin, made May the 29 1871

I hereby certify that the following is a correct record of said survey as made by me.

COUNTY BUILDING
IN CITY OF BELLOIT

(Signed) Edward Ruger
CRB

County Surveyor.

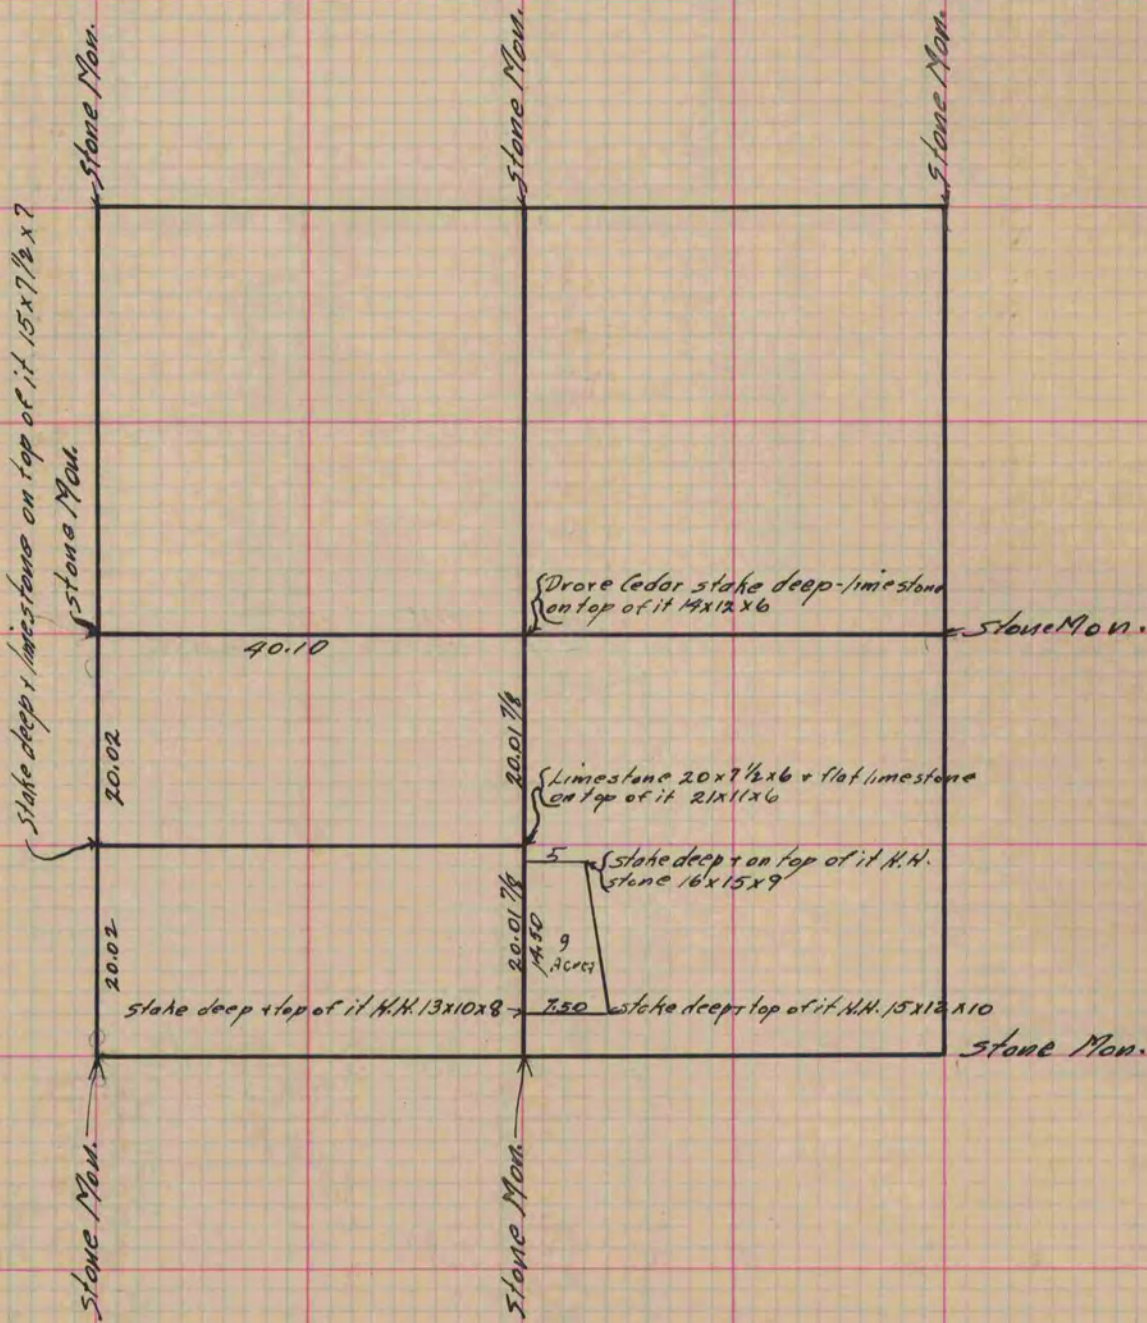

Copied from Page 91 Vol. 2 Original County Surveyor's Record.