

PLAT AND RECORD


Of a Survey on Section 25 T 3 R 12 E. of the 4 P. M. in Janesville Township

Rock County, Wisconsin, made May the 16th 1870

I hereby certify that the following is a correct record of said survey as made by me.

COUNTY BUILDING
IN CITY OF BELOIT

(Signed) Edward Ruger {Deputy
R.H.B. County Surveyor.

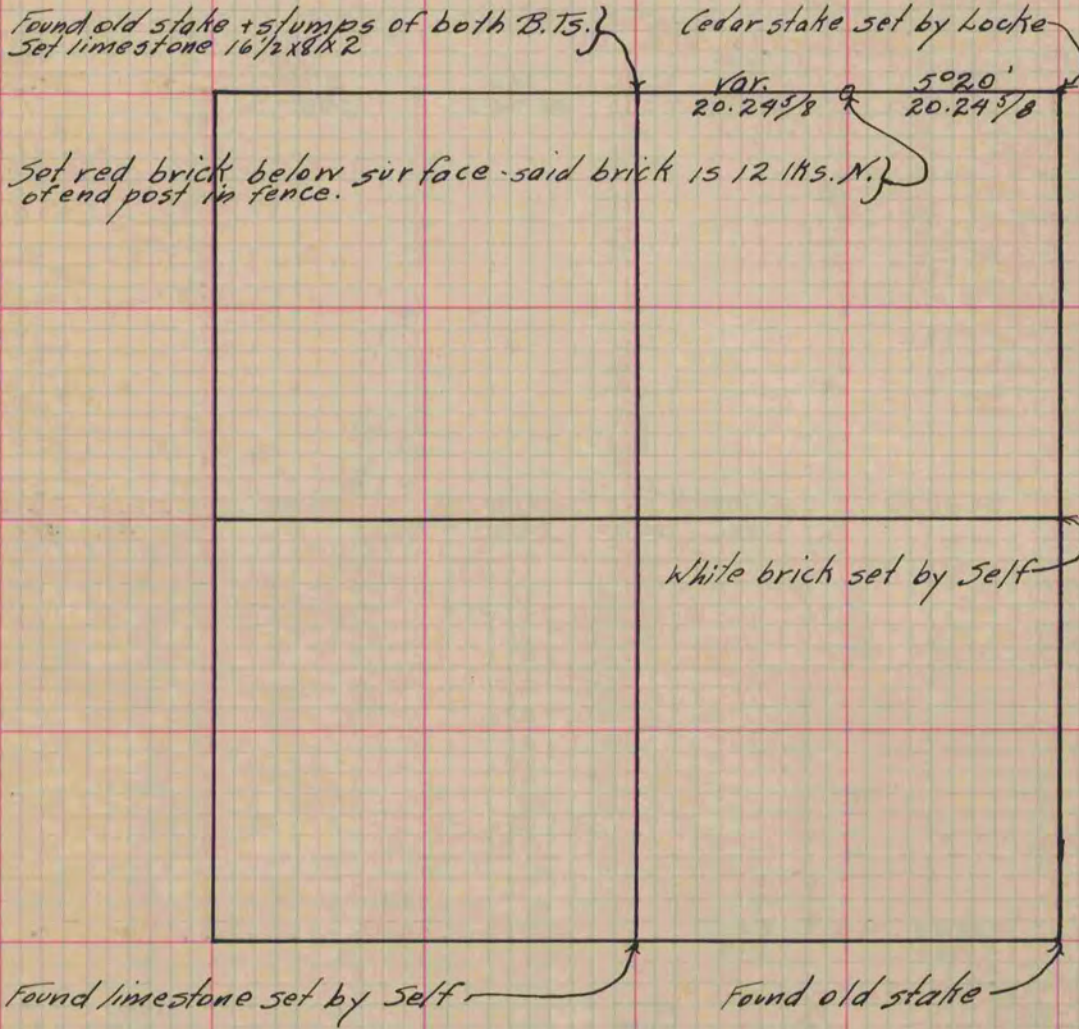

Copied from Upper 1/2 Page 23 Vol. 1. Original County Surveyor's Record.