


PLAT AND RECORD

Of a Survey on Section 35 T 1 R 10 E. of the 4 P. M. in Axon Township

Rock County, Wisconsin, made July the 27 + 28 1870

I hereby certify that the following is a correct record of said survey as made by me.

(Signed) Edward Ruger Deputy
R.H.B. County Surveyor.

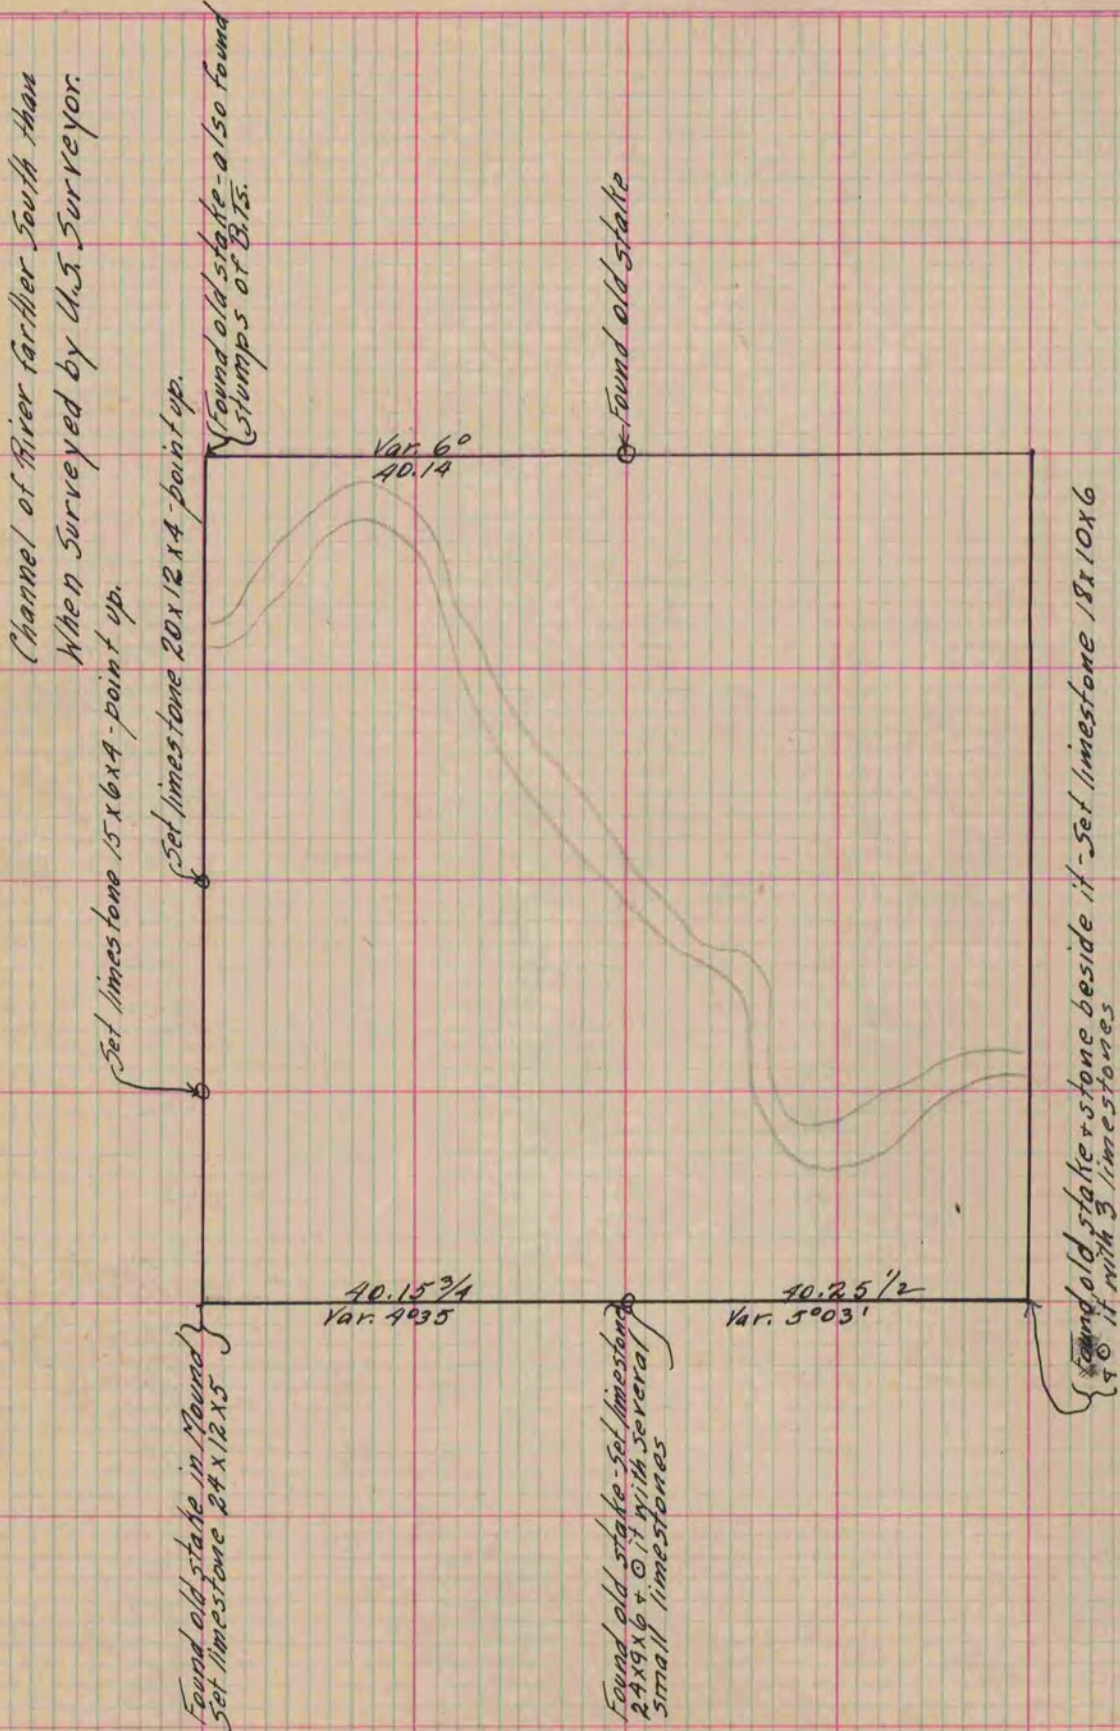

Copied from lower 1/2 Page 26 Vol. 2. Original County Surveyor's Record.