

PLAT AND RECORD

13


Of a Survey on Section 9 T 3 R 12 E. of the 4 P. M. in Janesville Township
Rock County, Wisconsin, made October the 23rd 1869

I hereby certify that the following is a correct record of said survey as made by me.

COUNTY BUILDING
IN CITY OF BELOIT

(Signed) Edward Ruger
R. H. B.

{Deputy
County Surveyor.

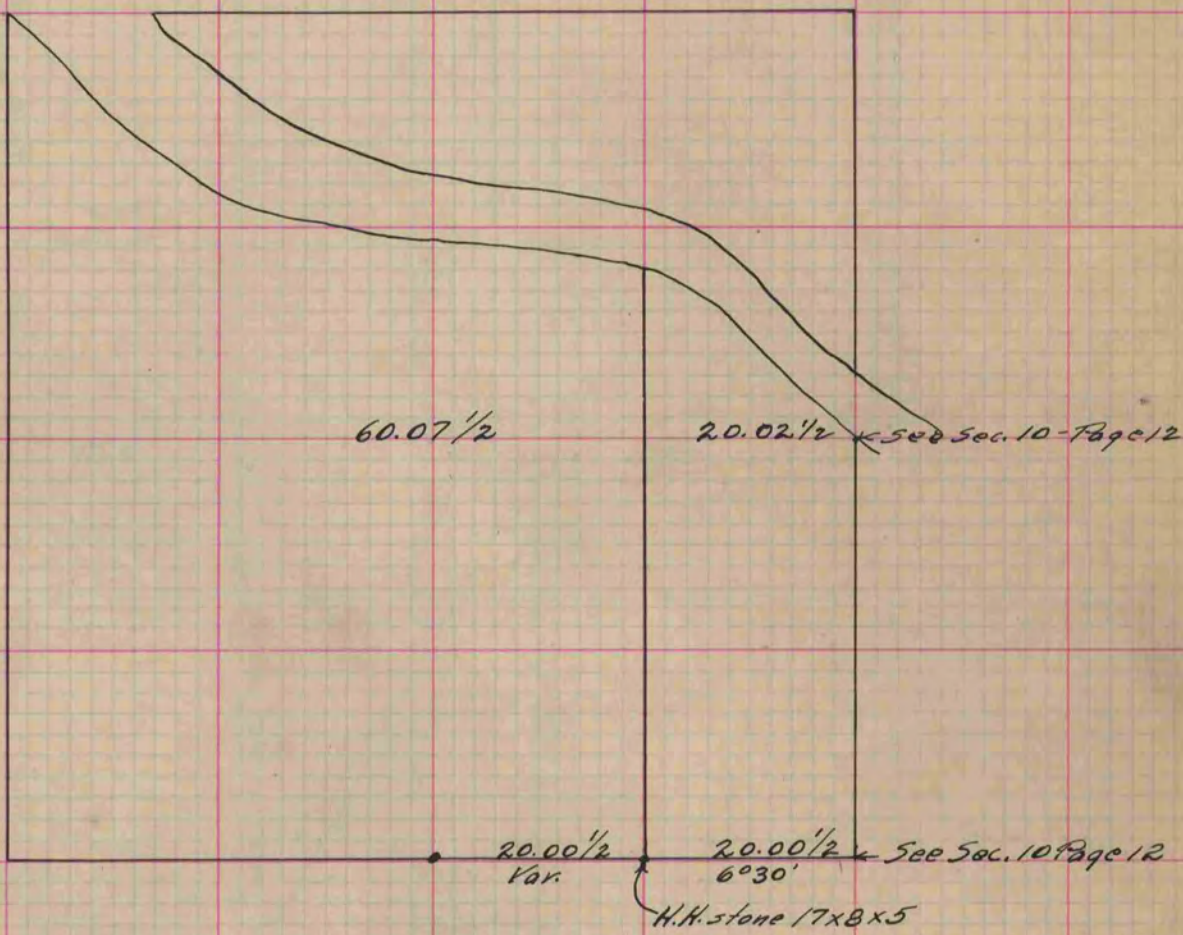

Copied from Page 13 Vol. 2 Original County Surveyor's Record.