

PLAT AND RECORD

73

Of a Survey on Section 13 T 1 R 10 E. of the 4 P. M. in Avon Township


Rock County, Wisconsin, made October the 23 1871

I hereby certify that the following is a correct record of said survey as made by me.

COUNTY BUILDING
IN CITY OF БЕЛОIT

(Signed) Edward Ruger
RMR

County Surveyor.

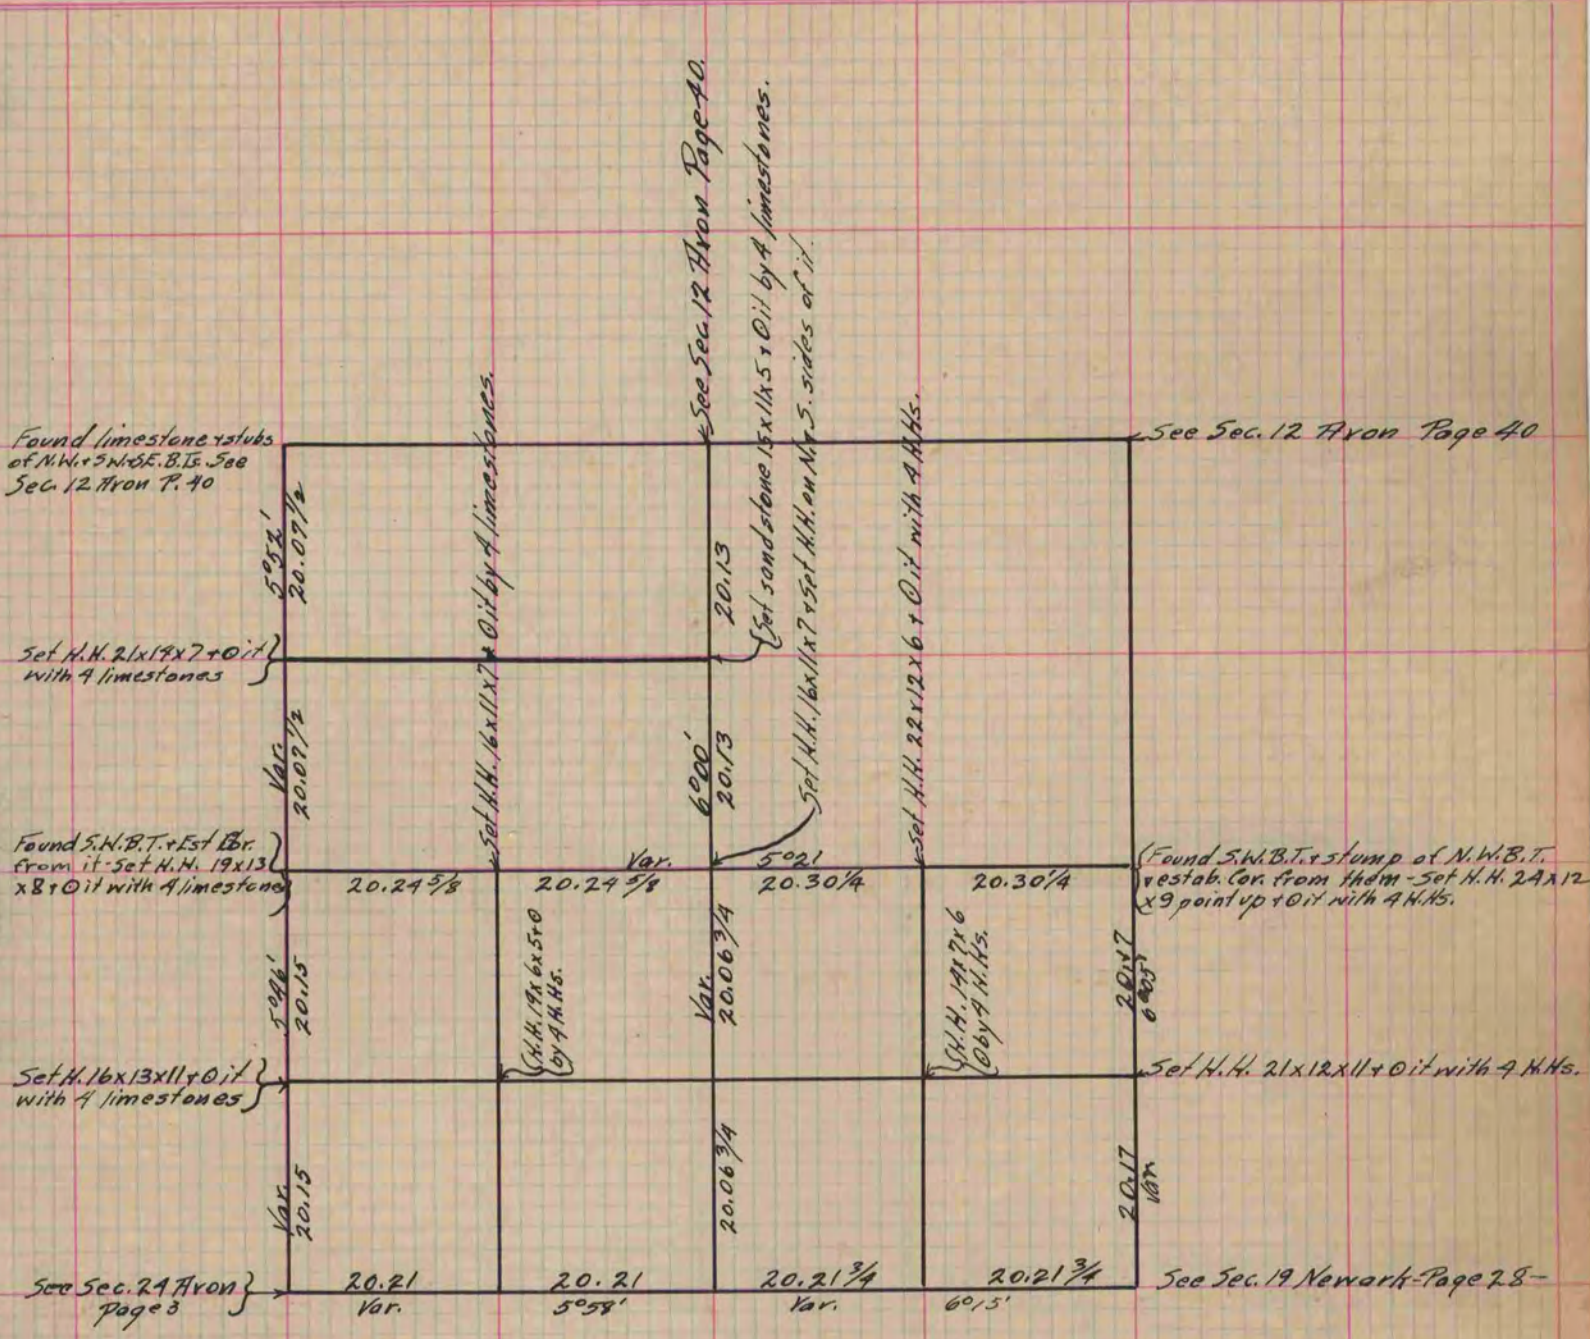

Copied from Page 44 Vol. 2. Original County Surveyor's Record.