

PLAT AND RECORD

COUNTY BUILDING
IN CITY OF БЕЛОИТ


Of a Survey on Section 28 T 4 R 10 E. of the 4 P. M. in Union Township

Rock County, Wisconsin, made June the 9th & 26th 1919

I hereby certify that the following is a correct record of said survey as made by me.

A. B. Battersman

County Surveyor.

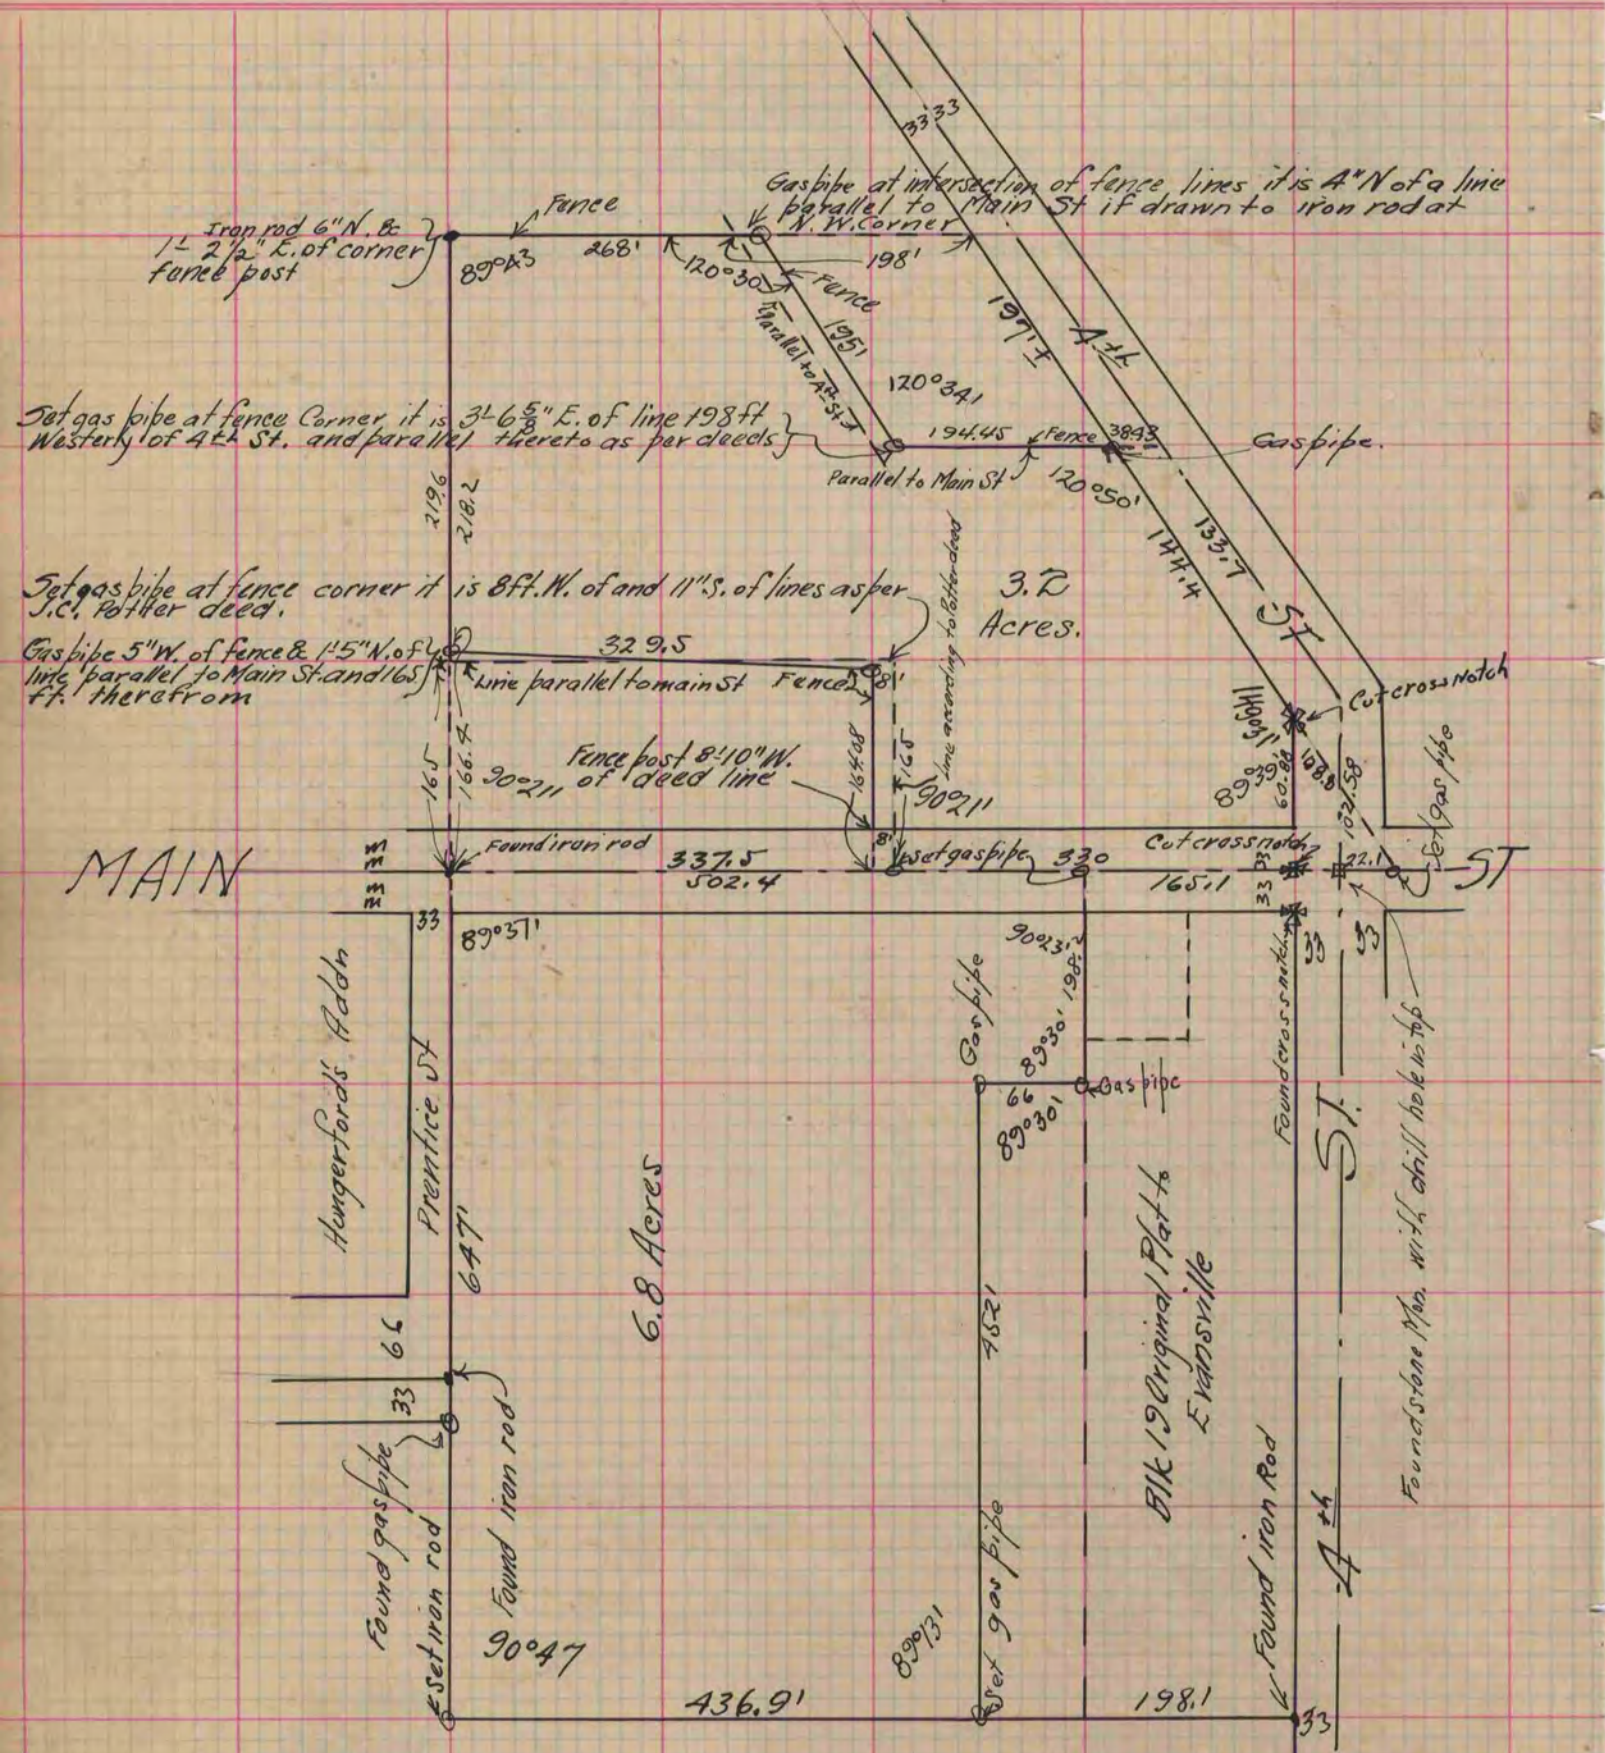

Order # 212
 For Mrs. S. Conradson
 B.A. P. 111-118