

# PLAT AND RECORD

Of a Survey on Section 27 T 1 R 12 E. of the 4 P. M. in Beloit Township


Rock County, Wisconsin, made November the 1919

I hereby certify that the following is a correct record of said survey as made by me.

*R. P. Battersman*

County Surveyor.

o = Gas Pipe Monuments

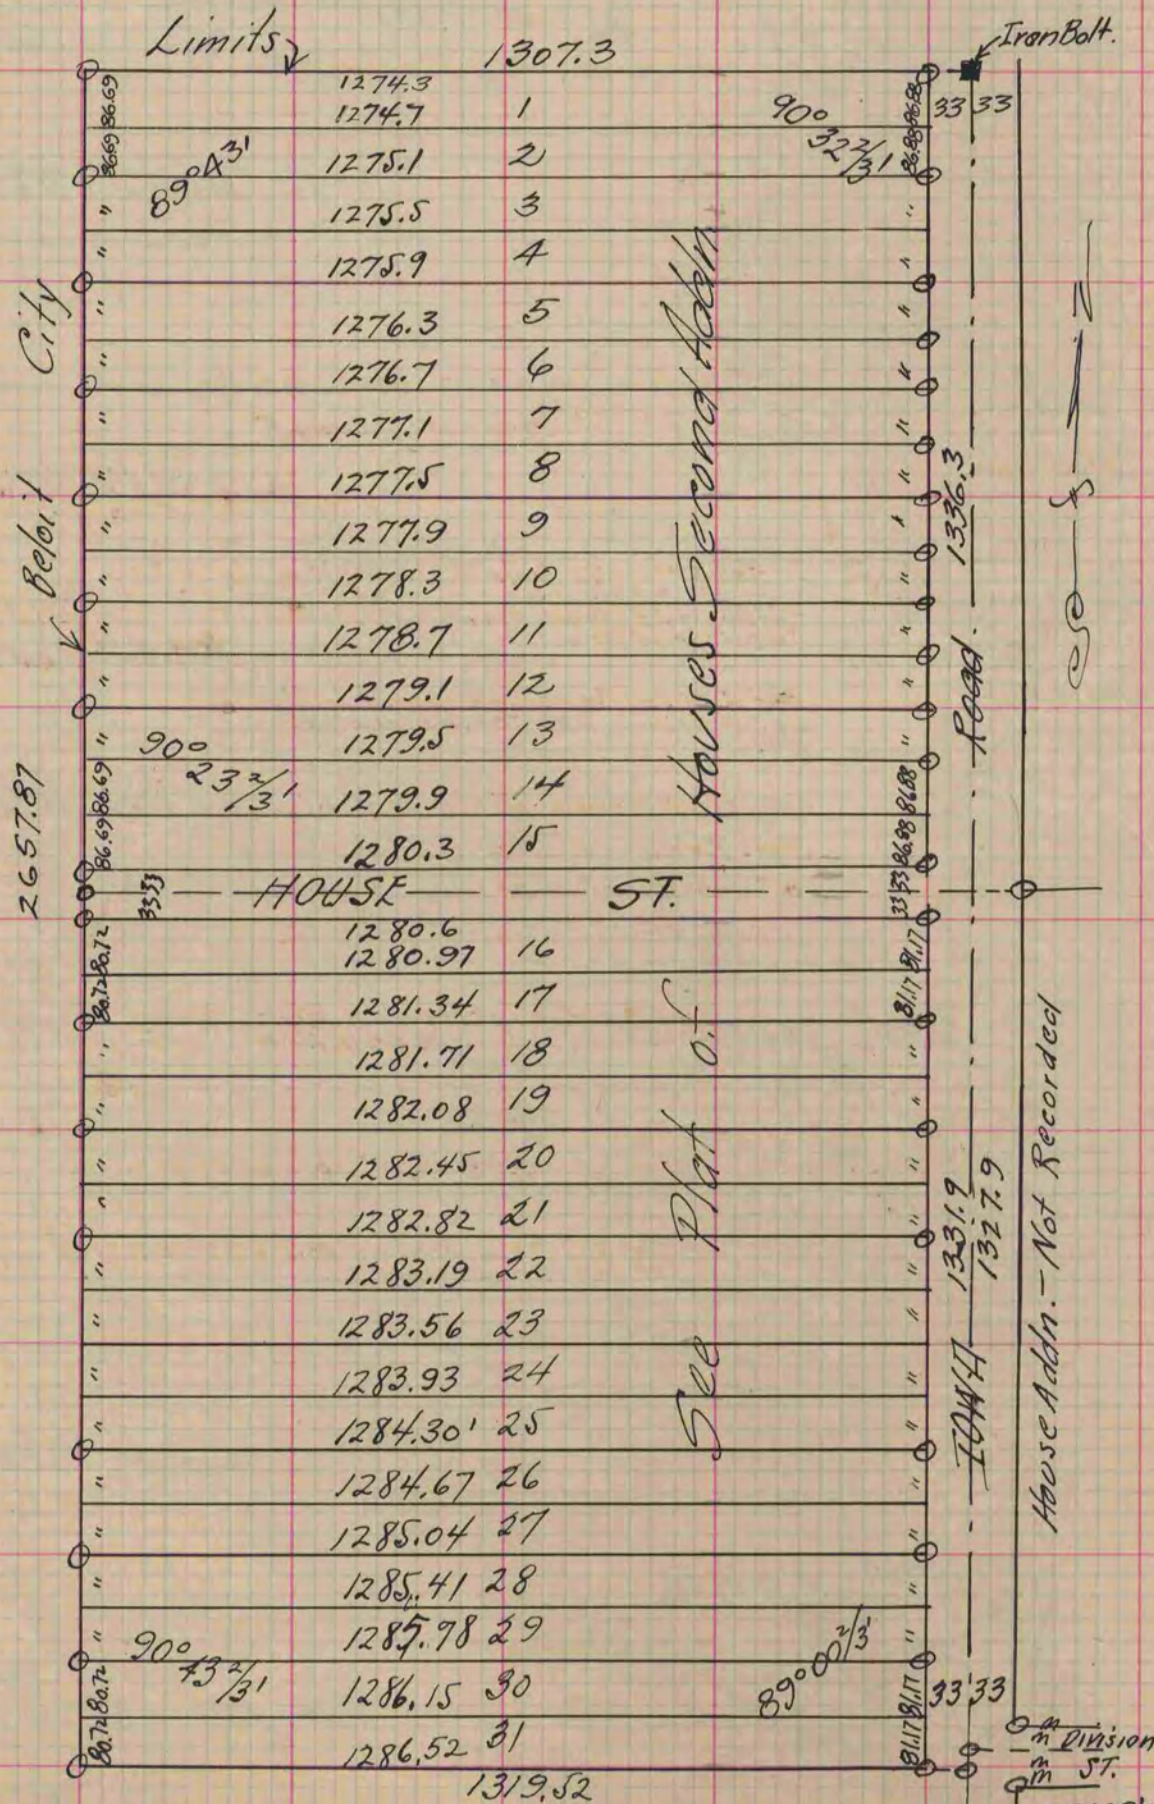

#290 For Sylvester House

STARR'S  
ADDN.