

COUNTY BUILDING  
IN CITY OF BELOIT


# PLAT AND RECORD

Of a Survey on Section 3 T 4 R 13 E. of the 4 P. M. in Milton Township

Rock County, Wisconsin, made January the 10<sup>th</sup> 1902

I hereby certify that the following is a correct record of said survey as made by me.

(Signed) C. V. Kerch  
R.H.B. County Surveyor.

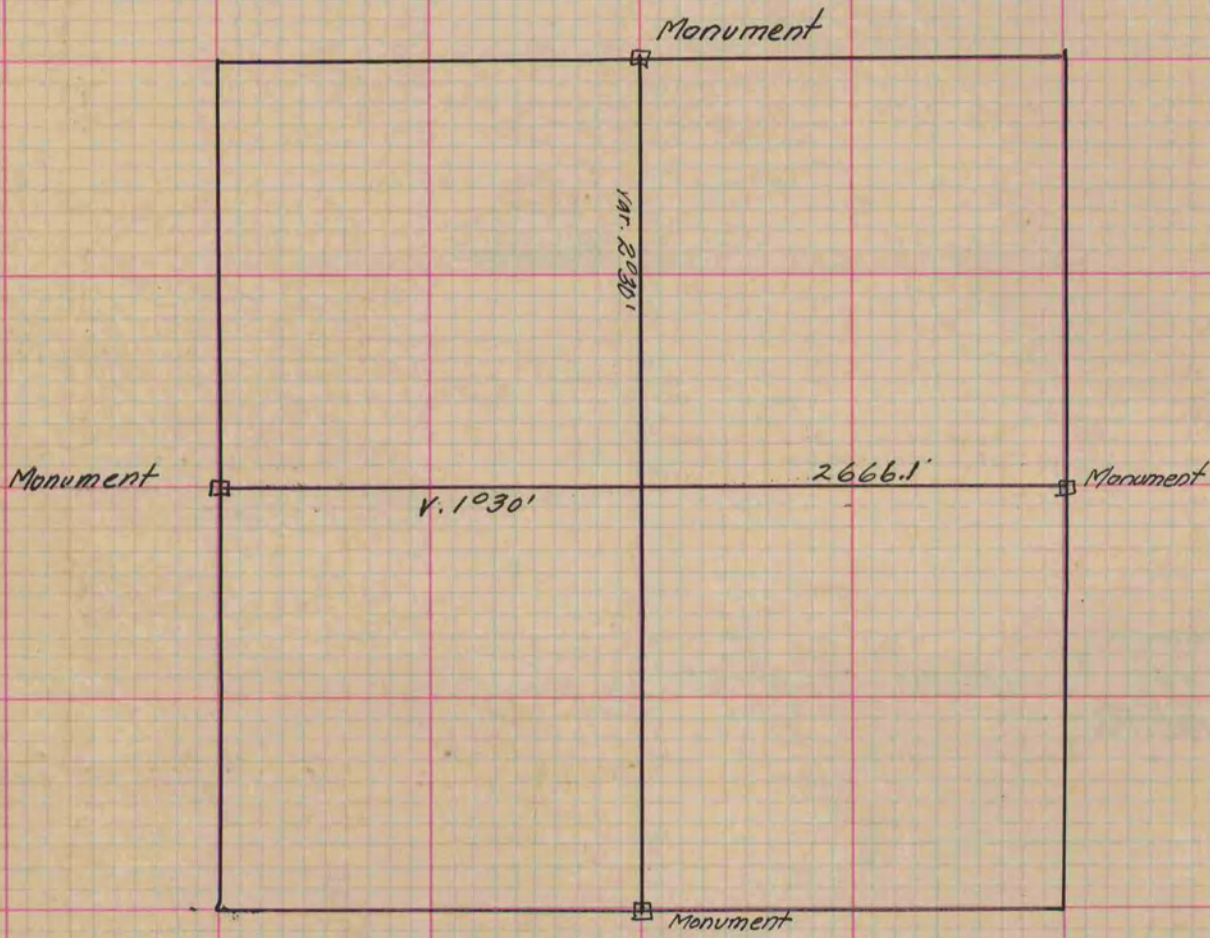

✓