

Paper weight-110# (minimum)

Black nonfading ink required

U.S. PUBLIC LAND SURVEY MONUMENT RECORD

For Public Land Survey Corners In:

WI ADMINISTRATIVE CODE A-E 7.08 REQUIREMENT

T. 4 N. R. 12 E. 4th P.M.

REV 10/23/2004

USMONREC.DWG

CORNER CODE INDEX

A	1	2	3	4	5	6	7	8	9	10	11	12	13	14	15	16	17	18	19	20	21	22	23	24	25	A
B																										B
C																										C
D																										D
E																										E
F																										F
G																										G
H																										H
J																										J
K																										K
L																										L
M																										M
N																										N
O																										O
P																										P
Q																										Q
R																										R
S																										S
T																										T
U																										U
V																										V
W																										W
X																										X
Y																										Y
Z																										Z

FULTON TWP
ROCK COUNTY WI

IF AVAILABLE
ROCK COUNTY COORDINATES PREFERRED

North _____ Elev. _____

East _____

Hor. Datum _____ Vert. Datum _____

LATITUDE _____ ELLIPS. HT. _____

LONGITUDE _____

NAD83(91) _____ NETWORK ADJ. YR _____

GPS (X) _____ TRAVERSE (X) _____

BASED ON THE FOLLOWING CONTROL:

PLACE MONUMENT SYMBOL AT PROPER LOCATION ON ABOVE INDEX

CORNER MONUMENT

WITNESS MONUMENT

BEARINGS ARE BASED ON: (a) _____

FIELD BOOK _____ PAGE # _____

SHEET 1 OF 3

SHOW A PLAN VIEW DRAWING DEPICTING THE CORNER MONUMENT AND SURROUNDING PHYSICAL FEATURES, INCLUDING THE EXCAVATION AREA AND DEPTH.

PLANNING & ZONING COMMITTEE ADOPTED THIS FORM ON 12/2/1982

CORNER CODE V-13

FU607^

(B) Describe any record evidence, monument evidence, occupational evidence, testimonial evidence or any other material evidence you considered, and whether the monument was found or placed.

- 1836 (AUG) BURNHAM EAST RANDOM BETWN SEC 28 & 33
5237.1 INT. EAST BOUNDY 23.76'? N FIRST RATE W & Y & BUR OAK OPENINGS
WEST CORRECTED BETWN 28 & 33
BUR OAK 12 IN DI
2618.22 SET 1/4 SEC POST BUR O 14 N29E 15.84' BUR O 16 S56W 40.26'
NO STATIONS
5237.1 TO CORNERS
- 1836 (AUG) BURNHAM NORTH BETWEEN SECTIONS 27 & 28
194.04 BUR OAK 12 IN DI
2640 SET 1/4 SEC POST BUR OAK 14 N9E 23.1' BUR OAK 10 S5EW 37.62'
NO STATIONS
5280 SET POST COR TO 21,22,27,28
BUR OAK 12 N79E 178.86' BUR OAK 12 N7OW 304.26' FIRST RATE BUR OAK OPENINGS
- 1836 (AUG) BURNHAM EAST RANDOM BETWN SECS 27 & 34
5326.2 INT. EAST BOUNDY 11.88' N GOOD 2ND RATE W & BUR OAK OPENINGS WEST 1/2 BROKEN
WEST CORRECTED BETWN SECS 27 & 34
NO STATIONS
2663.1 SET 1/4 SEC POST W. OAK 24 S60E 1.98' W. OAK 18 N26W 31.02'
4759.92 BUR OAK 12 IN DI
5326.2 TO CORNERS
- 1836 (AUG) BURNHAM NORTH BETWEEN SECTIONS 33 & 34
1225.62 YELLOW OAK 18 IN DI
2640 SET 1/4 SEC POST BUR OAK 24 S30W 25.74' BUR OAK 10 N6? 1/2E 16.5'
NO STATIONS
5280 SET POST COR TO 27,28,33, & 34 BUR OAK 12 S31 1/2W 39.6' BUR OAK 12 N3W 11.88' FIRST RATE BUR OAK OPENINGS
- 1870 RUGER VOL 2 PG 27 FD REMAINS OF OLD STAKE & STONE BESIDE OF IT, SET STAKE & SURROUNDED IT WITH 4 HARD HEAD STONES BL O 6 S80E 15.84' BL O 5 S3W 2.86'
- 1877 RUGER VOL 2 PG 229 COR EST. BY SELF SEE SEC 33 PG 20 VAR 6-03 2644.95 TO W 1/4 COR SEC 34
- 1974 LEE VOL 5 PG 20 SET CI MON 2669.91 TO S 1/4 COR SEC 27, 2641.68 TO W 1/4 COR SEC 27, & ANGLE 88-51-59 @ SW COR SEC 27 FROM W 1/4 COR TO S 1/4 CORNERS SEC 27
- 1985 BARNES V-11 2637.09 TO N 1/4 COR SEC 33. N 1/4 COR SEC 33 IS ON LINE WITH NW & NE CORNERS OF SEC 33
- 1985 BARNES VOL 6 PG 344 FD C.I. MON. 2637.09 TO N 1/4 COR SEC 33
- 1985 NORTHROP #7421 CAST IRON MON. OF RECORD BY C.S. 2638.80 TO E 1/4 COR SEC 28, 2637.08 TO S 1/4 COR SEC 28, ANGLE 91-07-25 @ SE COR SEC 28 FROM S 1/4 COR SEC 28 TO E 1/4 COR SEC 28, ANGLE 88-42-16 @ S 1/4 COR SEC 28 FROM N 1/4 COR SEC 28 TO SE CORNERS SEC 28
- 1985 NORTHROP #13744 C.I. S89-21-11W 2637.08 TO S 1/4 COR SEC 28 & NO-28-36E 2638.80 TO E 1/4 COR SEC 28
- 1999 COMBS #7548 CI ANGLE 90-46-25 @ S 1/4 COR SEC 27 TO GEN SEC 27 & ANGLE 89-08-20 @ S 1/4 COR SEC 27 FROM S 1/4 COR SEC 34 TO SW COR SEC 27

Donald
Barnes

11/30/07

SHEET 1 OF 3
CORNER CODE V-13

FU607

2000 NORTHROP #7634 CAST IRON MON. OF RECORD BY C.S.
2638.80 TO E 1/4 COR SEC 28, 2637.08 TO S 1/4 COR SEC 28,
ANGLE 91-07-25 @ SE COR SEC 28 FROM S 1/4 COR SEC 28
TO E 1/4 COR SEC 28, ANGLE 88-42-16 @ S 1/4 COR SEC 28
FROM N 1/4 COR SEC 28 TO SE CORNERS SEC 28
2002 NORTHROP #14234 C.I. 2637.08 TO S 1/4 COR SEC 28

FD CI. AT GRADE ON NORTH SIDE OF FENCE. FD PIPE 0.7'
ABOVE GRADE ON NORTH SIDE OF FENCE. PIPE IS 2' SOUTH OF
THE CI.

C) Was the corner restored through acceptance of (1) an obliterated evidence location, or, (2) a found perpetuated location?

ACCEPTED FD CI

D) Describe any material discrepancy between the location of the corner as restored or reestablished and the location of that corner as previously restored or reestablished by distance and direction. Show the discrepancy on the plan view drawing under (a), above. Show the distances between the corner as previously restored or reestablished and (1) the corner as restored or reestablished, and (2) to at least 4 of the witness monuments shown on the drawing in (a), above.

THERE IS A DISCREPANCY. THERE IS NO RECORD OF THE FD PIPE.

(E) Was the corner reestablished through lost corner proportionate methods? If so, show the method, including the directions and distances to other public land survey corners used as evidence or used for proportioning the corner location.

I, **Donald Barnes**, hereby certify that the corner location as identified by the corner code index was determined by me under my direction and control and that this U.S. Public Land Survey Monument Record is correct and complete to the best of my knowledge and belief.

Seal

SHEET 2 OF 3

Emboss




CORNER CODE

V-13

A.E. 7.08 REQUIREMENT

Donald Barnes
11/30/07

EMBOSSSED SEAL
Donald Barnes
 11/30/07

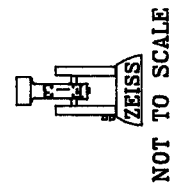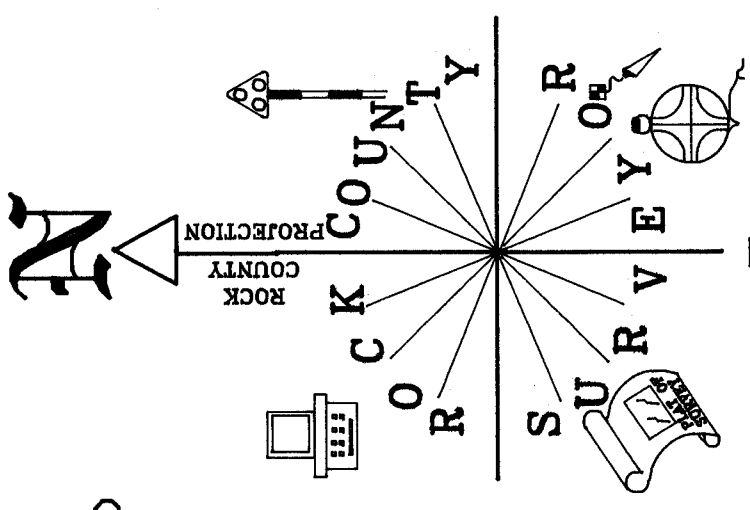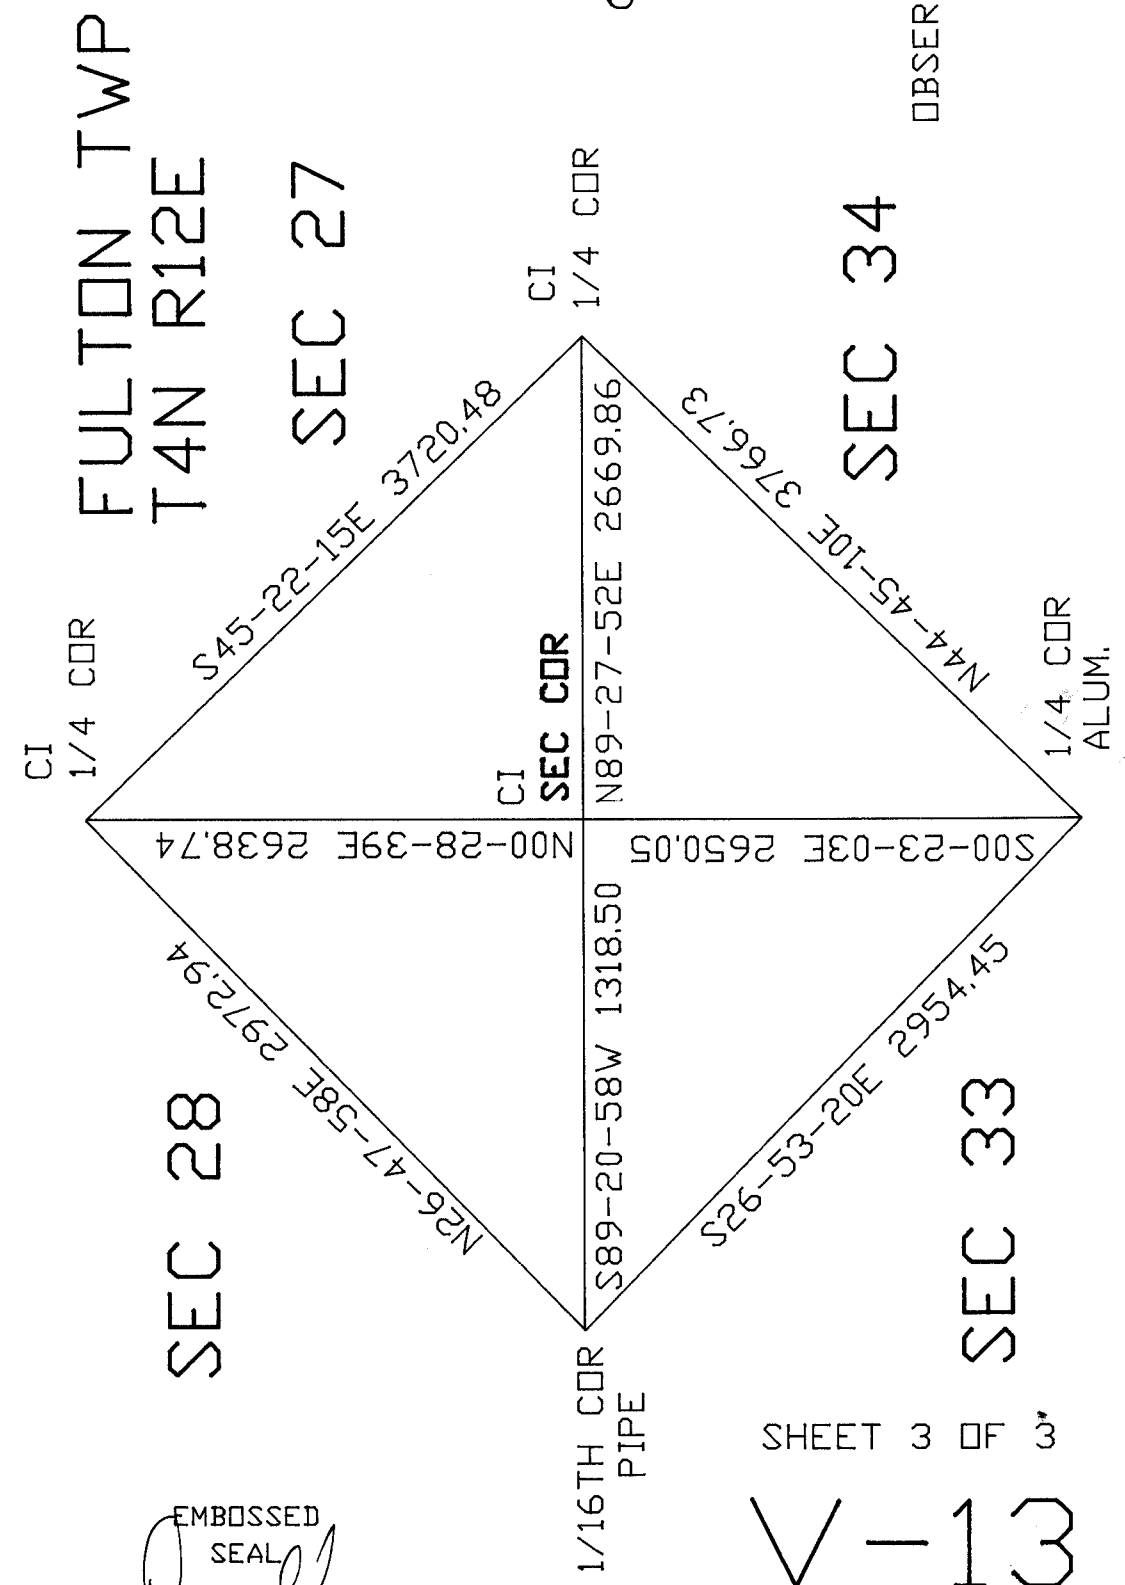

NOT TO SCALE

OBSERVATION SHEET 1142

SHEET 3 OF 3

V-13