

U.S. PUBLIC LAND SURVEY MONUMENT RECORD

For Public Land Survey Corners in the T. 4 N., R. 13 E.

CORNER CODE INDEX

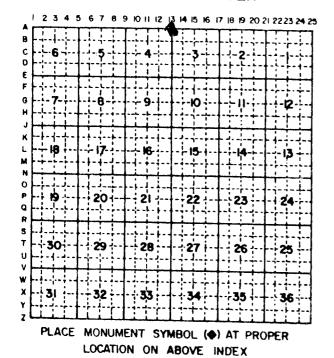

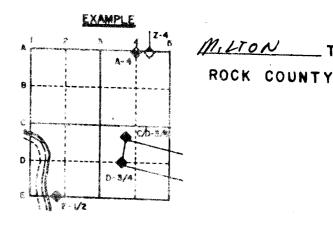

IF AVAILABLE STATE PLANE COORDINATES

North (Y)	AND THE RECORD OF THE PROPERTY	Eleve. (Z)
East (X)	A class in white complete their disappears processed in a process. It is a published the complete their disappears are processed in a published their disappears are processed as a published to the complete their disappears are processed as a publis	Zone
Hor. Datu	3.75	Vert. Datum

(a.)

CORNER MONUMENT

O WITNESS MONUMENT

COULD NOT PLACE RPFERENCE MONUMENTS.

MONUMENT IS IN FIELD and GROUND

WAS FROZEN.

BEARINGS APE BASED ON :

FIELD	воок		PAGE	#	94
		-		••	

SHOW A PLAN VIEW DRAWING DEPICTING THE CORNER MONUMENT AND SURROUNDING PHYSICAL FEATURES, INCLUDING THE EXCAVATION AREA AND DEPTH. THE CORNER MONUMENT SHALL HAVE THE FOLLOWING CHARACTERISTICS: 1) HAVE AT LEAST TWO PREDETERMINED BREAK-OFF POINTS. 2) IF BROKEN, LEAVE A PERMANENTLY MAGNETIZED REMNANT AT THE ORIGINAL POINT. 3) MUST BE EXTENDABLE. 4) THE CAP IS INSCRIBED: ROCK COUNTY SURVEY MONUMENT - PENALTY FOR DISTURBING MARKER. 5) OR AN EXISTING CUT LIMESTONE. AN IRON PIPE 1/2 x 1/2

CORNER CODE:

- (B) Describe any record evidence, monument evidence, occupational evidence, testimonial evidence or any other material evidence you considered, and whether the monument was found or placed.
- 1836 ORIG INTERSECTED NORTH BOUNDARY 35.64' WEST. SET POST CORNER TO 3 & 4. BUR OAK 8 S49W 44.88' & BUR OAK 8 S38E 21.78'. CALLS FOR 2662.44' TO E 1/4 CORNER OF SECTION 4.
- 1836 ORIG (SW CORNER OF SECTION 34 T5N R13E) SET POST CORNER SECTIONS 33 & 34. BUR OAK 10 N53E 24.42' & BUR OAK 11 N44 1/2W 143.22'. CALLS FOR 2640 TO S 1/4 CORNER OF SECTION 34 & 2640 TO S 1/4 CORNER OF SECTION 33.
- 1871 RUGER REMONUMENTATION FIELD NOTES. CONTINUED WEST ON NW 1/4 OF SECTION 3 ON A VAR 6-10', AT 5302.60' INTERSECTED WEST BOUNDARY LINE AT CORNER. FUND OLD STAKE AT CORNER ALSO FOUND SW BEARING TREE AND STUMP OF SE BEARING TREE ALSO FOUND OLD STAKE AT SW CORNER OF SECTION 34, TOWN 5 RANGE 13. ALSO FOUND NE BEARING TREE TO SAID CORNER THE NW CORNER OF SECTION 3 MILTON IS 35.64' WEST OF THE SW CORNER OF SECTION 34, TOWN 5, RANGE 13, ESTABLISHED NORTH 1/4 CORNER OF SECTION 3 ON THE TOWN LINE AND EQUIDISTANT FROM THE NE AND NW CORNERS OF SAID SECTION IT BEING 2651.30' DISTANT FROM EACH AND 27.64' WEST OF SOUTH 1/4 CORNER OF SECTION TOWN 5 RANGE 13.

1884 KOSHKONONG T5N R13E RESURVEY PLACED LIMESTONE

FOUND CUT LIMESTONE 8" DEEP. PLACED 5 MAGNETS 12" DEEP ON SOUTH SIDE AND CARSONITE POST ON SOUTH SIDE. 34.40' TO ALUMINUM MONUMENT AT THE SW CORNER OF SECTION 34 T5N R13E.

- C) Was the corner restored through acceptance of (1) an obliterated evidence location, or, (2) a found perpetuated location? ACCEPTED FOUND CUT LIMESTONE.
- D) Describe any material discrepancy between the location of the corner as restored or reestablished and the location of that corner as previously restored or reestablished by distance and direction. Show the discrepancy on the plan view drawing under (a), above. Show the distances between the corner as previously restored or reestablished and (1) the corner as restored or reestablished, and (2) to at least 4 of the witness monuments shown on the drawing in (a), above.
- (E) Was the corner reestablished through lost corner proportionate methods? If so, show the method, including the directions and distances to other public land survey corners used as evidence or used for proportioning the corner location.
- I, Donald Barnes, hereby certify that the corner points as identified by the corner code index were, in a field survey on, March 2, 1993, established, re-established, monumented, re-monumented, recovered or restored as expressed below and in conformance with the regulations and rules as required in the current manual of survey instructions of the United States Department of Interior, Bureau of Land Management.

Donald Baines 2/3/93

AFFIX YOUR LAND SURVEYOR SEAL

COUNTY SURVEYOR FILING DATA

Date of computer entry_____

Date microfilmed _____

Number of included sheets _____

CORNER CODE