

# U.S. PUBLIC LAND SURVEY MONUMENT RECORD

For Public Land Survey Corners in:

WI ADMINISTRATIVE CODE A-E 7.08 REQUIREMENT

T. 4 N., R. 12 E

### CORNER CODE INDEX

|   |    |   |   |   |   |   |   |   |   |    |    |    |    |    |    |    |    |    |    |    |    |    |    |    |    |  |
|---|----|---|---|---|---|---|---|---|---|----|----|----|----|----|----|----|----|----|----|----|----|----|----|----|----|--|
| A | 1  | 2 | 3 | 4 | 5 | 6 | 7 | 8 | 9 | 10 | 11 | 12 | 13 | 14 | 15 | 16 | 17 | 18 | 19 | 20 | 21 | 22 | 23 | 24 | 25 |  |
| B |    |   |   |   |   |   |   |   |   |    |    |    |    |    |    |    |    |    |    |    |    |    |    |    |    |  |
| C | 6  |   |   |   |   |   |   |   |   |    |    |    |    |    |    |    |    |    |    |    |    |    |    |    |    |  |
| D |    |   |   |   |   |   |   |   |   |    |    |    |    |    |    |    |    |    |    |    |    |    |    |    |    |  |
| E |    |   |   |   |   |   |   |   |   |    |    |    |    |    |    |    |    |    |    |    |    |    |    |    |    |  |
| F |    |   |   |   |   |   |   |   |   |    |    |    |    |    |    |    |    |    |    |    |    |    |    |    |    |  |
| G | 1  |   |   |   |   |   |   |   |   |    |    |    |    |    |    |    |    |    |    |    |    |    |    |    |    |  |
| H |    |   |   |   |   |   |   |   |   |    |    |    |    |    |    |    |    |    |    |    |    |    |    |    |    |  |
| J |    |   |   |   |   |   |   |   |   |    |    |    |    |    |    |    |    |    |    |    |    |    |    |    |    |  |
| K |    |   |   |   |   |   |   |   |   |    |    |    |    |    |    |    |    |    |    |    |    |    |    |    |    |  |
| L | 18 |   |   |   |   |   |   |   |   |    |    |    |    |    |    |    |    |    |    |    |    |    |    |    |    |  |
| M |    |   |   |   |   |   |   |   |   |    |    |    |    |    |    |    |    |    |    |    |    |    |    |    |    |  |
| N |    |   |   |   |   |   |   |   |   |    |    |    |    |    |    |    |    |    |    |    |    |    |    |    |    |  |
| O |    |   |   |   |   |   |   |   |   |    |    |    |    |    |    |    |    |    |    |    |    |    |    |    |    |  |
| P | 19 |   |   |   |   |   |   |   |   |    |    |    |    |    |    |    |    |    |    |    |    |    |    |    |    |  |
| Q |    |   |   |   |   |   |   |   |   |    |    |    |    |    |    |    |    |    |    |    |    |    |    |    |    |  |
| R |    |   |   |   |   |   |   |   |   |    |    |    |    |    |    |    |    |    |    |    |    |    |    |    |    |  |
| S |    |   |   |   |   |   |   |   |   |    |    |    |    |    |    |    |    |    |    |    |    |    |    |    |    |  |
| T | 30 |   |   |   |   |   |   |   |   |    |    |    |    |    |    |    |    |    |    |    |    |    |    |    |    |  |
| U |    |   |   |   |   |   |   |   |   |    |    |    |    |    |    |    |    |    |    |    |    |    |    |    |    |  |
| V |    |   |   |   |   |   |   |   |   |    |    |    |    |    |    |    |    |    |    |    |    |    |    |    |    |  |
| W |    |   |   |   |   |   |   |   |   |    |    |    |    |    |    |    |    |    |    |    |    |    |    |    |    |  |
| X | 31 |   |   |   |   |   |   |   |   |    |    |    |    |    |    |    |    |    |    |    |    |    |    |    |    |  |
| Y |    |   |   |   |   |   |   |   |   |    |    |    |    |    |    |    |    |    |    |    |    |    |    |    |    |  |
| Z |    |   |   |   |   |   |   |   |   |    |    |    |    |    |    |    |    |    |    |    |    |    |    |    |    |  |

FULTON TWP

ROCK COUNTY WI

IF AVAILABLE  
ROCK COUNTY COORDINATES PREFERRED

North \_\_\_\_\_ Elev. \_\_\_\_\_

East \_\_\_\_\_

Hor. Datum \_\_\_\_\_ Vert. Datum \_\_\_\_\_

LATITUDE \_\_\_\_\_ ELLIPS. HT. \_\_\_\_\_

LONGITUDE \_\_\_\_\_

GPS (X) \_\_\_\_\_ TRAVERSE (X) \_\_\_\_\_

BASED ON THE FOLLOWING CONTROL:

PLACE MONUMENT SYMBOL  AT PROPER LOCATION ON ABOVE INDEX

CORNER MONUMENT

WITNESS MONUMENT

(a)

BEARINGS ARE BASED ON:

FIELD BOOK \_\_\_\_\_ PAGE # \_\_\_\_\_

SHEET 1 OF 3

SHOW A PLAN VIEW DRAWING DEPICTING THE CORNER MONUMENT AND SURROUNDING PHYSICAL FEATURES, INCLUDING THE EXCAVATION AREA AND DEPTH.

PLANNING & ZONING COMMITTEE ADOPTED THE ABOVE FORM ON 12/2/1982

CORNER CODE A-3

FU502

(B) Describe any record evidence, monument evidence, occupational evidence, testimonial evidence or any other material evidence you considered, and whether the monument was found or placed.

1833 (SEP 20) MULLETT BRINK VAR 8-40 EAST ON SOUTH SIDE  
SECTION 31 5N 12E

2534.4 SET QUARTER SEC POST WHITE OAK 10 N15W 59.4';  
WHITE OAK 12 N79E 140.58'

4488 ENTER WET PRAIRIE

5280 SET POST CORNER SECTIONS 31 & 32 BUR OAK 12  
N77 1/2 W 836.22' BUR OAK 2 N59E 802.56'  
LAND LEVEL SECOND RATE AND THINLY TIMBERED  
WITH WHITE BUR & BLACK OAK

1847 PIERCE TWP RD REC BK 1 PG 10 BEGINNING AT THE  
QUARTER SECTION POST ON NORTH SIDE OF SEC 6, RUN  
FROM SAID PLACE OF BEGINNING ON THE QUARTER LINE OF  
SEC 6 & 7 S8-15E 10,543.5' THEN SOUTH 47-45W 1914';  
THENCE S35W 528' INTERSECTING THE TERRITORIAL RD  
NORTHERLY OF FULTON MILLS MAKING 12,988.14'. THE  
ABOVE DESCRIBED ROADS ARE 66 FT WIDE

1865 LOCKE VOL 1 PG 226 SET STAKE OAK AND SURROUNDED BY  
3 RED BRICK 93.39' EAST OF S 1/4 COR SEC 31. 2688.18 TO  
NE COR SEC 6, 2655.68 TO CENTER OF SEC 6, & 5315.81  
TO S 1/4 COR SEC 6

1911 HINTZE ALBION T5N R12E SET SOUTH 1/4 OF SEC 31 ON  
STRAIGHT LINE AND AT PROPORTIONATE DISTANCES. W.O.  
15" N7W 104'; BOX ELDER 6" N88-20E 231'; N89-16E  
2666.0' TO SE COR SEC 31 & S89-16W 2510.4' TO SW COR  
SEC 31. CORNER IS WEST OF N 1/4 COR SEC 6. SET  
ACCORDING TO LOCATION NEAR LOST TOWNSHIP CORNERS.  
AT DANE COUNTY CORNERS, HINTZE INSTALLED CONCRETE  
MONUMENTS. THE DIFFERENCE IN BEARING OF LINES  
BETWEEN SECTION CORNERS GIVES THE TRUE DEVIATION  
FROM THE STRAIGHT LINE. SOME OF THE BEARINGS ARE  
MAGNETIC, CHECKED BY MEASUREMENTS, AND THE RESTARE  
TRANSIT LINES CHECKED BY OBSERVATIONS ON POLARIS. I  
HEREBY CERTIFY THAT THE DISTANCES AND BEARINGS ARE  
CORRECT ACCORDING TO SURVEY MADE UNDER THE  
PROVISIONS OF CHAPTER, 39 SECTION 825 OF THE REVISED  
STATUTES OF WISCONSIN AND IN ACCORDANCE WITH THE  
RULES ESTABLISHED BY THE UNITED STATES LAND OFFICE.

1970 ?? OCT 7 & 8 VOL 1 PG 226 BELOIT SET OF RECORDS. DUG  
& FD CONC. MON.

19?? WPL #1044 S 1/4 COR SEC 31 STONE OR CONC. - LEGEND  
S89-23-46W (TRUE NORTH) 2559.47 TO NW COR SEC 6 &  
N89-16-43E 2668.13 TO SE COR SEC 31. ANGLE @ S 1/4 COR  
SEC 31 FROM SW TO SE COR SEC 31 179-52-57

1979 CLAYTON #6553 & VOL 5 PG 549 TIES TO HOUSE & 12" GMP  
CAST IRON MONUMENT 93.39 EAST OF S 1/4 COR SEC 31 A  
CONCRETE MON. IN CAST IRON VALVE BOX.

1993 LEUEMBERGER CSM VOL 16 PG 356 FD CI 5300.41 TO S 1/4  
COR SEC 6

1994 NORTHROP #9491 CI MON 93.29 EAST OF S 1/4 COR SEC 31.  
CONC. MON IN C.I. VALVE BOX AT S 1/4 COR SEC 31. 5300.54'  
FROM S 1/4 COR SEC 6 TO N 1/4 COR SEC 6, ANGLE OF 91-10-35  
@ S 1/4 COR SEC 6 FROM SW TO N 1/4 COR SEC 6.

Donald Barnes  
1/17/07

FU502

FOUND C.I. UNDER BUSH @ N 1/4 COR SEC 6. DUG & FOUND MON BOX WITH CONCRETE MON & A 3/8" PIN IN TOP @ S 1/4 COR SEC 31. MONUMENT BOX TOP IS 0.4' BELOW PVMT SURFACE & TOP OF CONCRETE MONUMENT IS 1.5' PVMT SURFACE.

I WAS UNABLE TO FIND DOCUMENTATION FOR THE INSTALLATION OF THE C.I. IT APPEARS THAT SOMEONE USED LOCK'S 1865 CALL OF A RECORD DISTANCE OF 93.39' EAST OF THE S 1/4 COR SEC 31. HINTZE DECLARED THE S 1/4 COR SEC 31 AS LOST AND ESTABLISHED IT ON A STRAIGHT LINE AND A SINGLE PROPORTIONATE DISTANCE. HE APPEARED TO HAVE IGNORED LOCK'S 1865 CORNER.

C) Was the corner restored through acceptance of (1) an obliterated evidence location, or, (2) a found perpetuated location?

ACCEPTED BOTH PERPETUATED LOCATIONS.

D) Describe any material discrepancy between the location of the corner as restored or reestablished and the location of that corner as previously restored or reestablished by distance and direction. Show the discrepancy on the plan view drawing under (a), above. Show the distances between the corner as previously restored or reestablished and (1) the corner as restored or reestablished, and (2) to at least 4 of the witness monuments shown on the drawing in (a), above.

NONE

(E) Was the corner reestablished through lost corner proportionate methods? If so, show the method, including the directions and distances to other public land survey corners used as evidence or used for proportioning the corner location.

NO

I, **Donald Barnes**, hereby certify that the corner location as identified by the corner code index was determined by me under my direction and control and that this U.S. Public Land Survey Monument Record is correct and complete to the best of my knowledge and belief.

*Donald Barnes*  
1/17/07  
Emboss


SHEET 2 OF 3

CORNER CODE **A-3**

A.E. 7.08 REQUIREMENT

DANE COUNTY


ROCK COUNTY

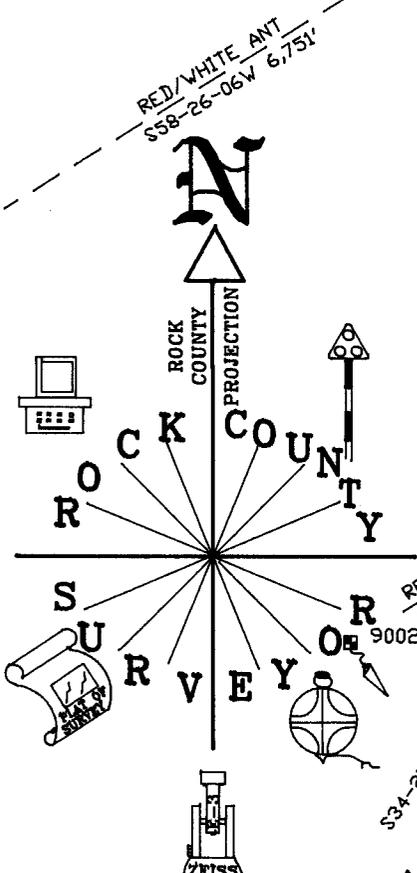

NOT TO SCALE  
OBSERVATION SHEETS 395, 419, & 4622

N 1/4 COR  
SEC 6  
FULTON TWP  
T4N R12E

*Barnes*  
EMBEDDED SEAL  
1/17/07

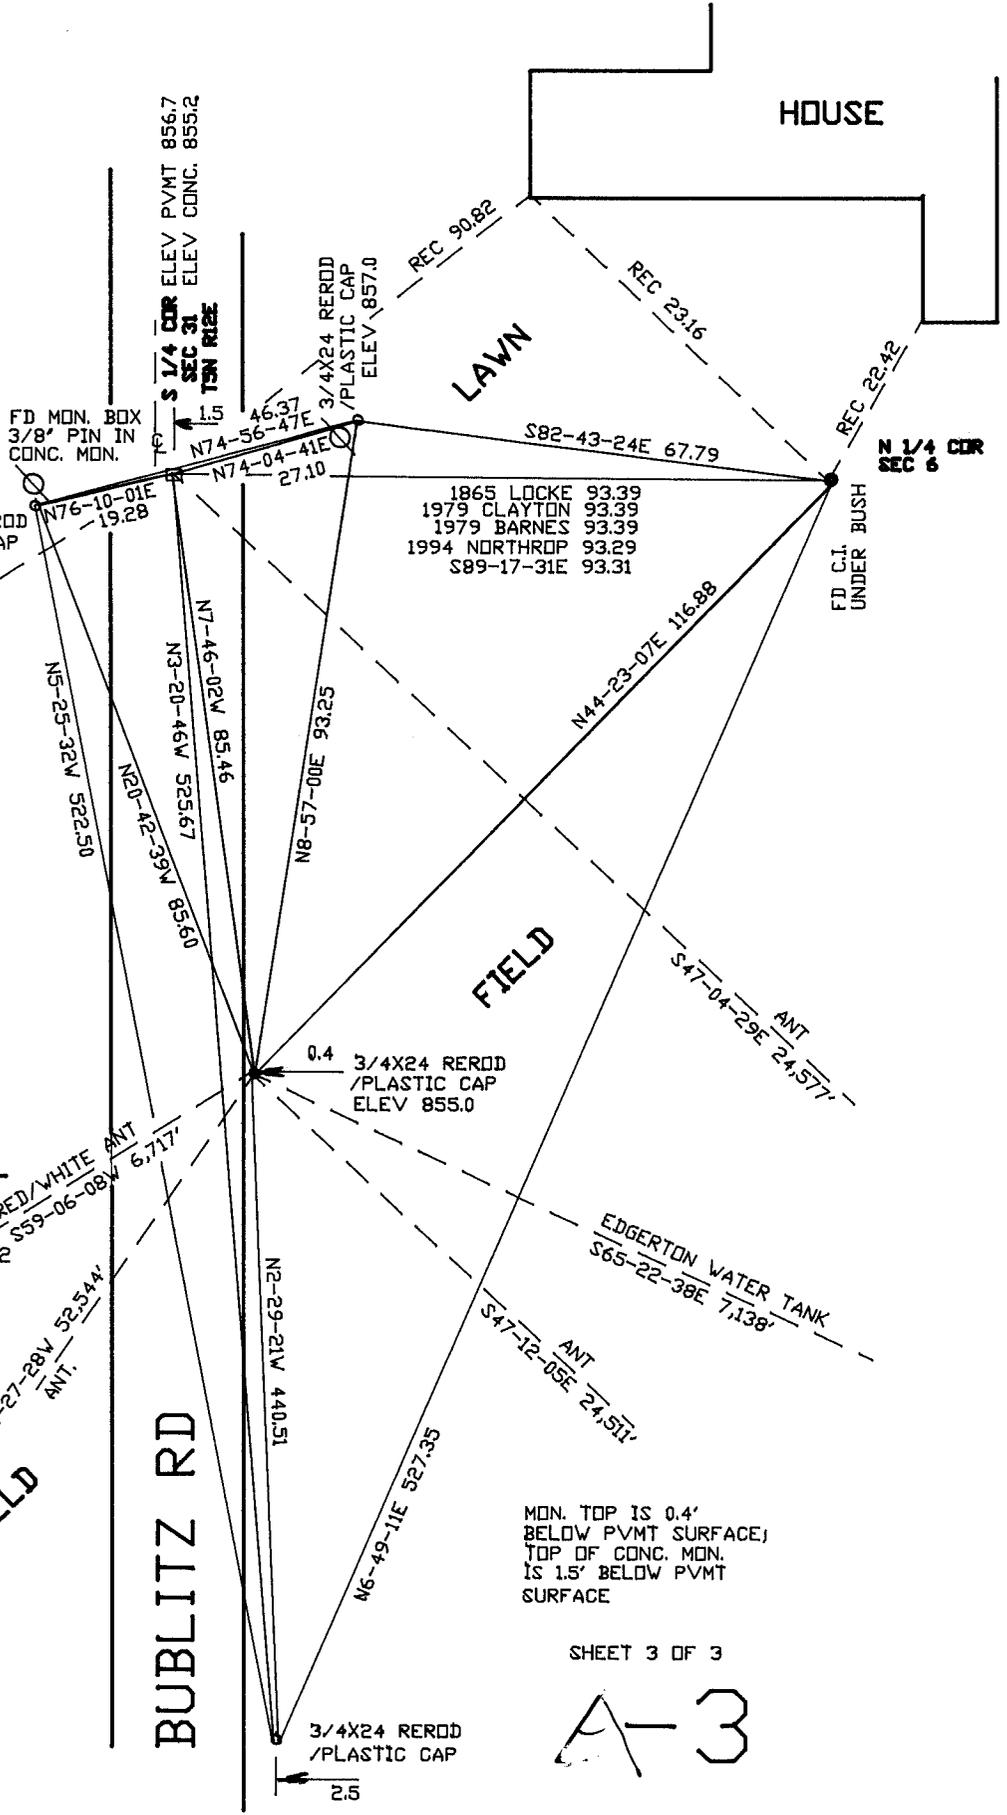

SHEET 3 OF 3  
A-3