

U.S. PUBLIC LAND SURVEY MONUMENT RECORD

For Public Land Survey Corners in:

WI ADMINISTRATIVE CODE A-E 7.08 REQUIREMENT

T. 1 N., R. 12 E 4th P.M.

CORNER CODE INDEX

A	1	2	3	4	5	6	7	8	9	10	11	12	13	14	15	16	17	18	19	20	21	22	23	24	25
B	6																								
C																									
D																									
E																									
F																									
G	1	8																							
H																									
I																									
J																									
K																									
L	18	17	16	15	14	13	12	11	10	9	8	7	6	5	4	3	2	1							
M																									
N																									
O	19	20	21	22	23	24	25	26	27	28	29	30	31	32	33	34	35	36							
P																									
Q																									
R																									
S	30	29	28	27	26	25	24	23	22	21	20	19	18	17	16	15	14	13	12	11	10	9	8	7	
T																									
U																									
V																									
W																									
X																									
Y																									
Z																									

BELoit TWP
ROCK COUNTY, WI

IF AVAILABLE
ROCK COUNTY COORDINATES PREFERRED

North 233,269.48 Elev.

East 477,816.94

Hor. Datum COUNTY Vert. Datum


LATITUDE ELLIPS. HT.

LONGITUDE

ELLIPS. DATUM
NAD83(91) COUNTY LIST

GPS (X) TRAVERSE (X)

BASED ON THE FOLLOWING CONTROL:

PLACE MONUMENT SYMBOL  AT PROPER LOCATION ON ABOVE INDEX

 CORNER MONUMENT

WITNESS MONUMENT

(a)

BEARINGS ARE BASED ON:

FIELD BOOK PAGE #

SHEET 1 OF 2

SHOW A PLAN VIEW DRAWING DEPICTING THE CORNER MONUMENT AND SURROUNDING PHYSICAL FEATURES, INCLUDING THE EXCAVATION AREA AND DEPTH.

PLANNING & ZONING COMMITTEE ADOPTED THE ABOVE FORM ON 12/2/1982

CORNER CODE A-11

BE506

(B) Describe any record evidence, monument evidence, occupational evidence, testimonial evidence or any other material evidence you considered, and whether the monument was found or placed.

1851 McVEAN VOL 1 PG 1 STATE NOTHING ABOUT MONUMENT. CALLS FOR 2838 TO CENTER SEC 4 & 5435.76 TO S 1/4 COR SEC 4.

1952 LEE VOL 6 PG 143 2690.59 TO NE COR SEC 4 & 2690.59 TO NW COR SEC 4

1971 LEE VOL 6 PG 143 2690.59 TO NW & NE CORNERS OF SEC 4.

1974 LEE MAP #209 ANGLE OF 91-49-42 @ NE COR SEC 4 FROM E 1/4 SEC 4 TO N 1/4 COR SEC 4, ANGLE OF 89-47-35 @ NW COR SEC 4 FROM N 1/4 COR SEC 4 TO W 1/4 COR SEC 4, 2898.04 TO CENTER OF SEC 4, & ANGLE OF 180-50-02 @ N 1/4 COR SEC 4 FROM NE COR TO NW CORNERS OF SEC 4.

1990 BARNES ROCK TWP FIELD BK#3 PG 43. SEARCHED & FOUND NOTHING. S 1/4 COR SEC 33 IS IN DRAINAGE DITCH.

ESTABLISHED CORNER MID WAY ON LINE WITH NE CORNER SEC 4 & SW COR SEC 33 ROCK TWP. POSITION IS IN MARCH AREA. DID NOT PLACE MONUMENT.

C) Was the corner restored through acceptance of (1) an obliterated evidence location, or, (2) a found perpetuated location?

NO

D) Describe any material discrepancy between the location of the corner as restored or reestablished and the location of that corner as previously restored or reestablished by distance and direction. Show the discrepancy on the plan view drawing under (a), above. Show the distances between the corner as previously restored or reestablished and (1) the corner as restored or reestablished, and (2) to at least 4 of the witness monuments shown on the drawing in (a), above.

POSITION DETERMINED FROM LEE'S 1974 SURVEY IS WITHIN 3.3' OF THE COMPUTED POSITION.

(E) Was the corner reestablished through lost corner proportionate methods? If so, show the method, including the directions and distances to other public land survey corners used as evidence or used for proportioning the corner location.

YES

I, Donald Barnes, hereby certify that the corner points as identified by the corner code index were, established, re-established, monumented, re-monumented, recovered or restored as expressed below and in conformance with the regulations and rules as required in the current manual of survey instructions of the United States Department of Interior, Bureau of Land Management.

COUNTY SURVEYOR FILING DATA

seal

Donald Barnes
Oct 9, 1998

Date of computer entry _____

Date microfilmed _____



Number of included sheets _____

CORNER CODE

EMBOSS LAND SURVEYOR SEAL.

A-E 7.08 REQUIREMENT

A-11

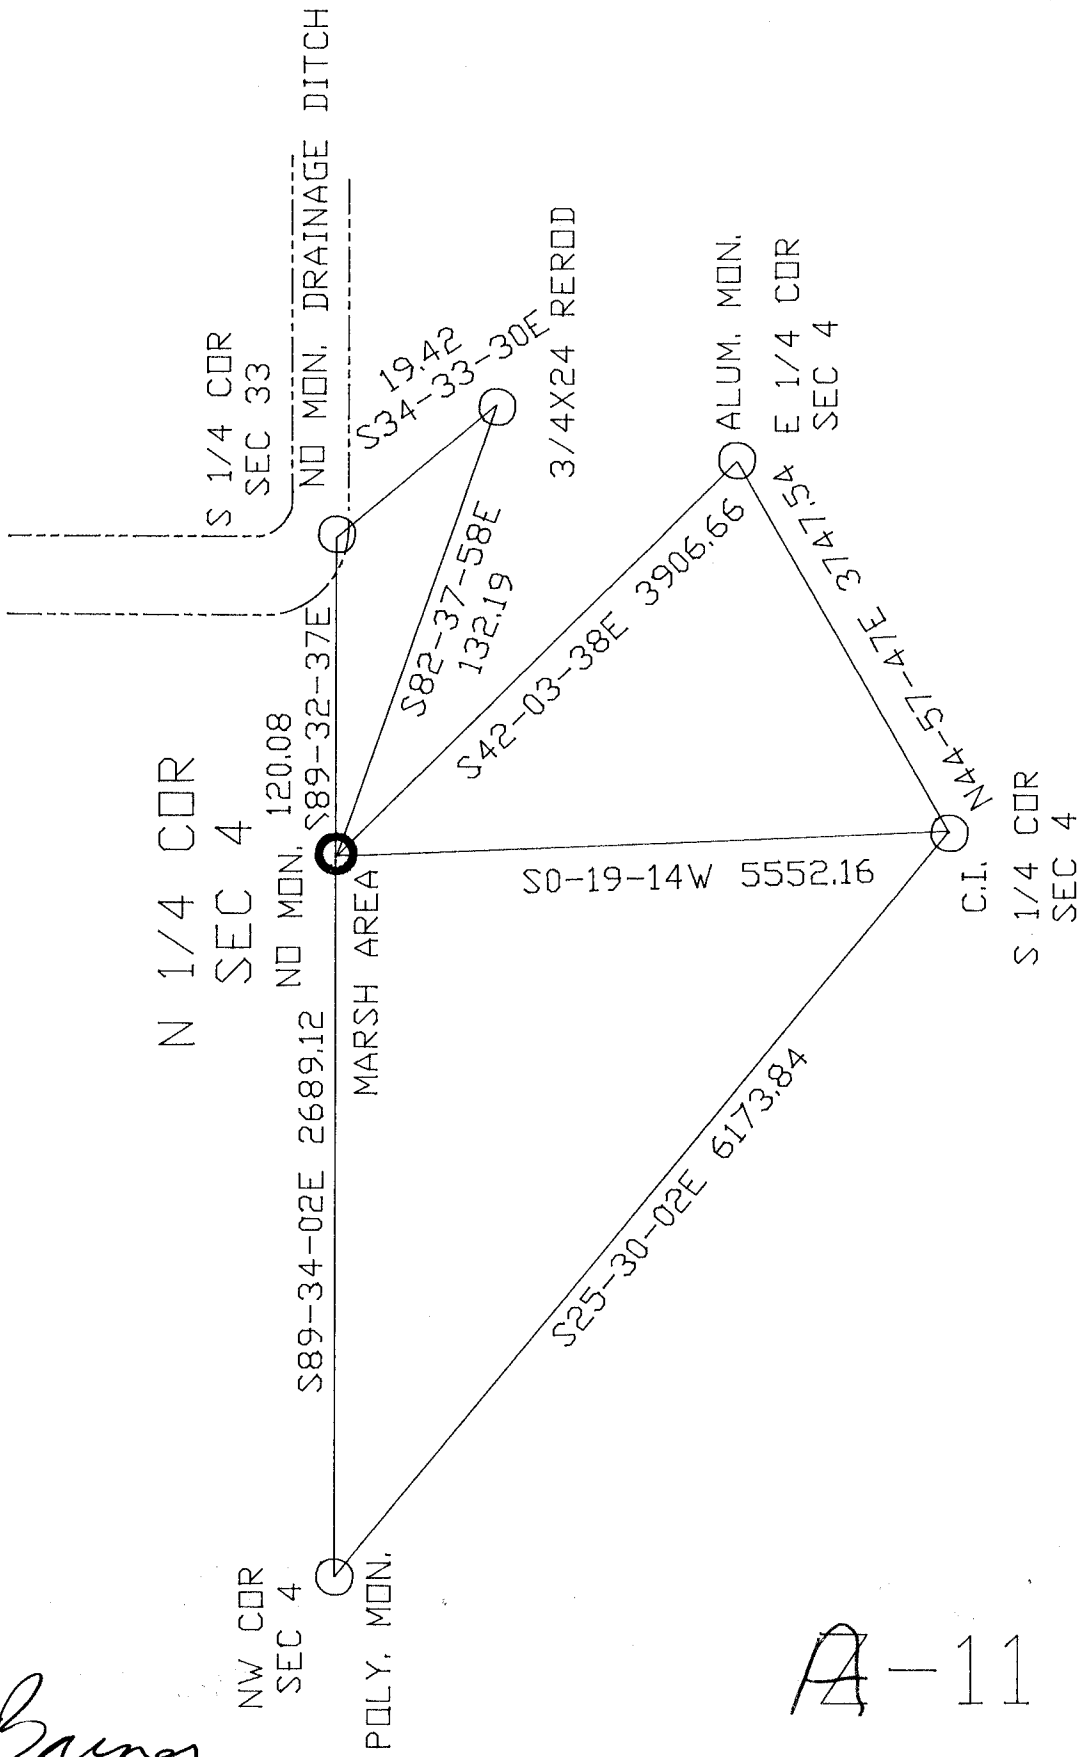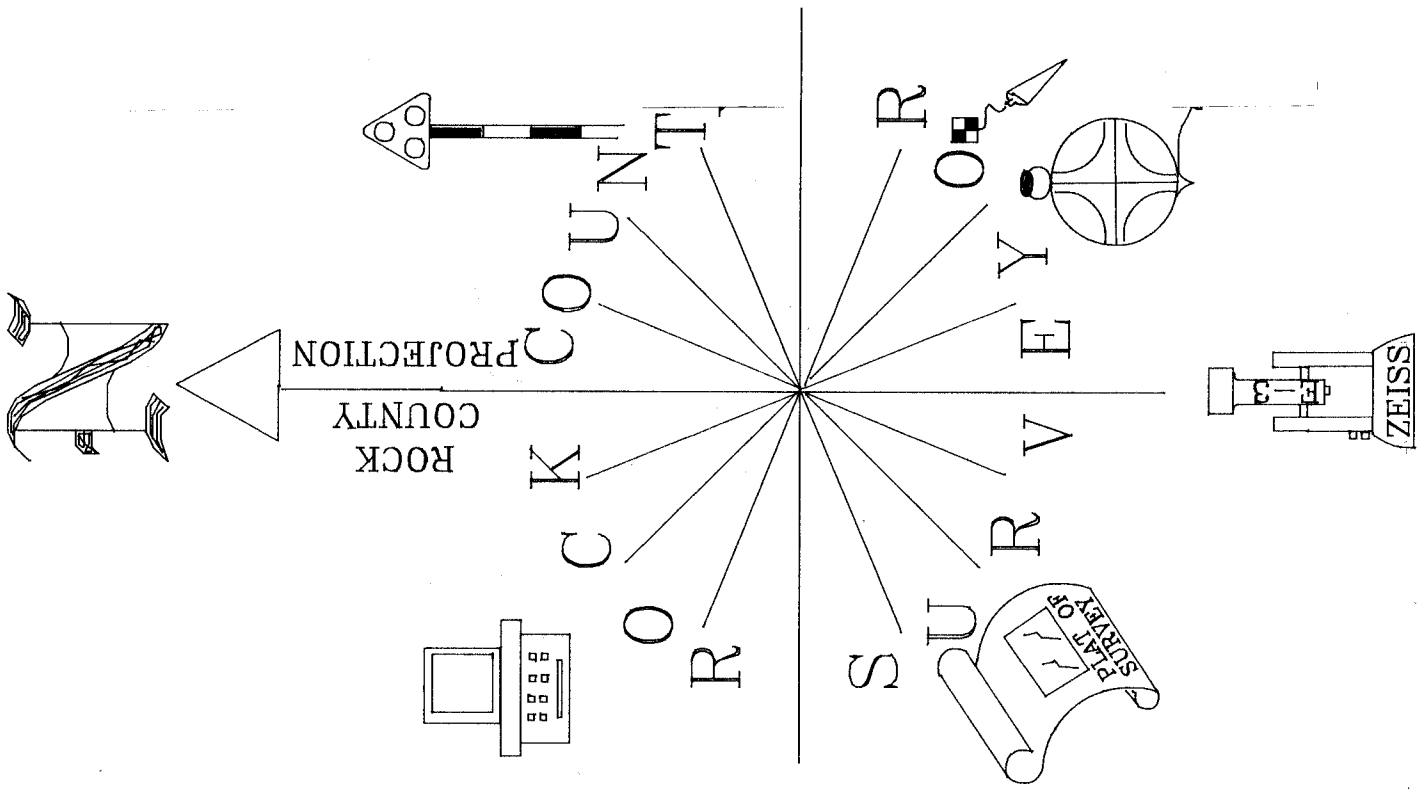

Donald Brunas
Oct 9, 1998

A-11