

U.S. PUBLIC LAND SURVEY MONUMENT RECORD

For Public Land Survey Corners in:

WI ADMINISTRATIVE CODE A-E 7.08 REQUIREMENT

T. 12 N., R. 12 E

BELOIT TWP TWP

CORNER CODE INDEX

ROCK COUNTY WI

A	1	2	3	4	5	6	7	8	9	10	11	12	13	14	15	16	17	18	19	20	21	22	23	24	25
B																									
C	6																								
D																									
E																									
F																									
G	7	8	9	10	11	12																			
H																									
I																									
J																									
K	18	17	16	15	14	13																			
L																									
M																									
N																									
O	19	20	21	22	23	24																			
P																									
Q																									
R																									
S																									
T	30	29	28	27	26	25																			
U																									
V																									
W																									
X	31	32	33	34	35	36																			
Y																									
Z																									

IF AVAILABLE
ROCK COUNTY COORDINATES PREFERRED

North 206,430.37 Elev. _____

East 477,686.02

Hor. Datum COUNTY Vert. Datum _____

LATITUDE _____ ELLIPS. HT. _____

LONGITUDE _____

GPS (X) _____ TRAVERSE (X) _____

BASED ON THE FOLLOWING CONTROL:

PLACE MONUMENT SYMBOL AT PROPER LOCATION ON ABOVE INDEX

CORNER MONUMENT

WITNESS MONUMENT

(a)

BEARINGS ARE BASED ON:

FIELD BOOK _____ PAGE # _____

SHEET 1 OF 2

SHOW A PLAN VIEW DRAWING DEPICTING THE CORNER MONUMENT AND SURROUNDING PHYSICAL FEATURES, INCLUDING THE EXCAVATION AREA AND DEPTH.

PLANNING & ZONING COMMITTEE ADOPTED THE ABOVE FORM ON 12/2/1982

CORNER CODE V-11

BE606

(B) Describe any record evidence, monument evidence, occupational evidence, testimonial evidence or any other material evidence you considered, and whether the monument was found or placed.

- 1834 HARRISON EAST ON RAND. BET 28 & 33
 990 TO THE SUMMIT OF HIGH GROUND
 2640 TEMPY 1/4 SEC COR
 5291.88 INT. EAST BOUNDARY 7.92 NORTH OF POST
 COR. WEST BET 28 & 23
 2645.94 QUARTER SEC COR. SET POST & RAISED MOUND
 5291.88 SEC COR.
- 1931 SUNNY VOL 3 PG 189 FOUND IRON PIPE MON & REFERENCED SAME.
- 1937 SUNNY VOL 3 PG 326 FD PIPE 2689.0 TO NW COR SEC 33 & 2622 TO CENTER SEC 33.
- 1952 DOT STH 81 2692.50 TO NW COR SEC 33 & 2691.90 TO NE COR SEC 33
- 1969 BATTERMAN VOL 4 PG 461 FD 4 POINT SCRIBE & 1 1/2 " PIPE AT N 1/4 COR SEC 33. REFERENCED SAME.
- 1976 BARNES VOL 5 PG 129 FD HOLE IN CUT "X" REFERENCED SAME.
- 1979 BARNES VOL 6 PG 3 FD CUT "X" & UNDER THAT FD 1X24 PIPE. REPLACED WITH ALUM. MON.
- 1987 LEUENBERGER MAP #12803 2621.34 TO CENTER OF SEC 33.

FOUND ALUM. MON.

C) Was the corner restored through acceptance of (1) an obliterated evidence location, or, (2) a found perpetuated location?
ACCEPTED FOUND LOCATION.

D) Describe any material discrepancy between the location of the corner as restored or reestablished and the location of that corner as previously restored or reestablished by distance and direction. Show the discrepancy on the plan view drawing under (a), above. Show the distances between the corner as previously restored or reestablished and (1) the corner as restored or reestablished, and (2) to at least 4 of the witness monuments shown on the drawing in (a), above.

(E) Was the corner reestablished through lost corner proportionate methods? If so, show the method, including the directions and distances to other public land survey corners used as evidence or used for proportioning the corner location.
NO

I, Donald Barnes, hereby certify that the corner points as identified by the corner code index were, in a field survey on, established, re-established, monumented, re-monumented, recovered or restored as expressed below and in conformance with the regulations and rules as required in the current manual of survey instructions of the United States Department of Interior, Bureau of Land Management.

WISCONSIN
 COUNTY SURVEYOR
 seal
Donald Barnes
 OCT 16, 1998
 EMBOSS LAND SURVEYOR SEAL

COUNTY SURVEYOR FILING DATA

Date of computer entry _____



Date microfilmed _____

Number of included sheets _____

CORNER CODE

A-E 7.08 REQUIREMENT

V-11

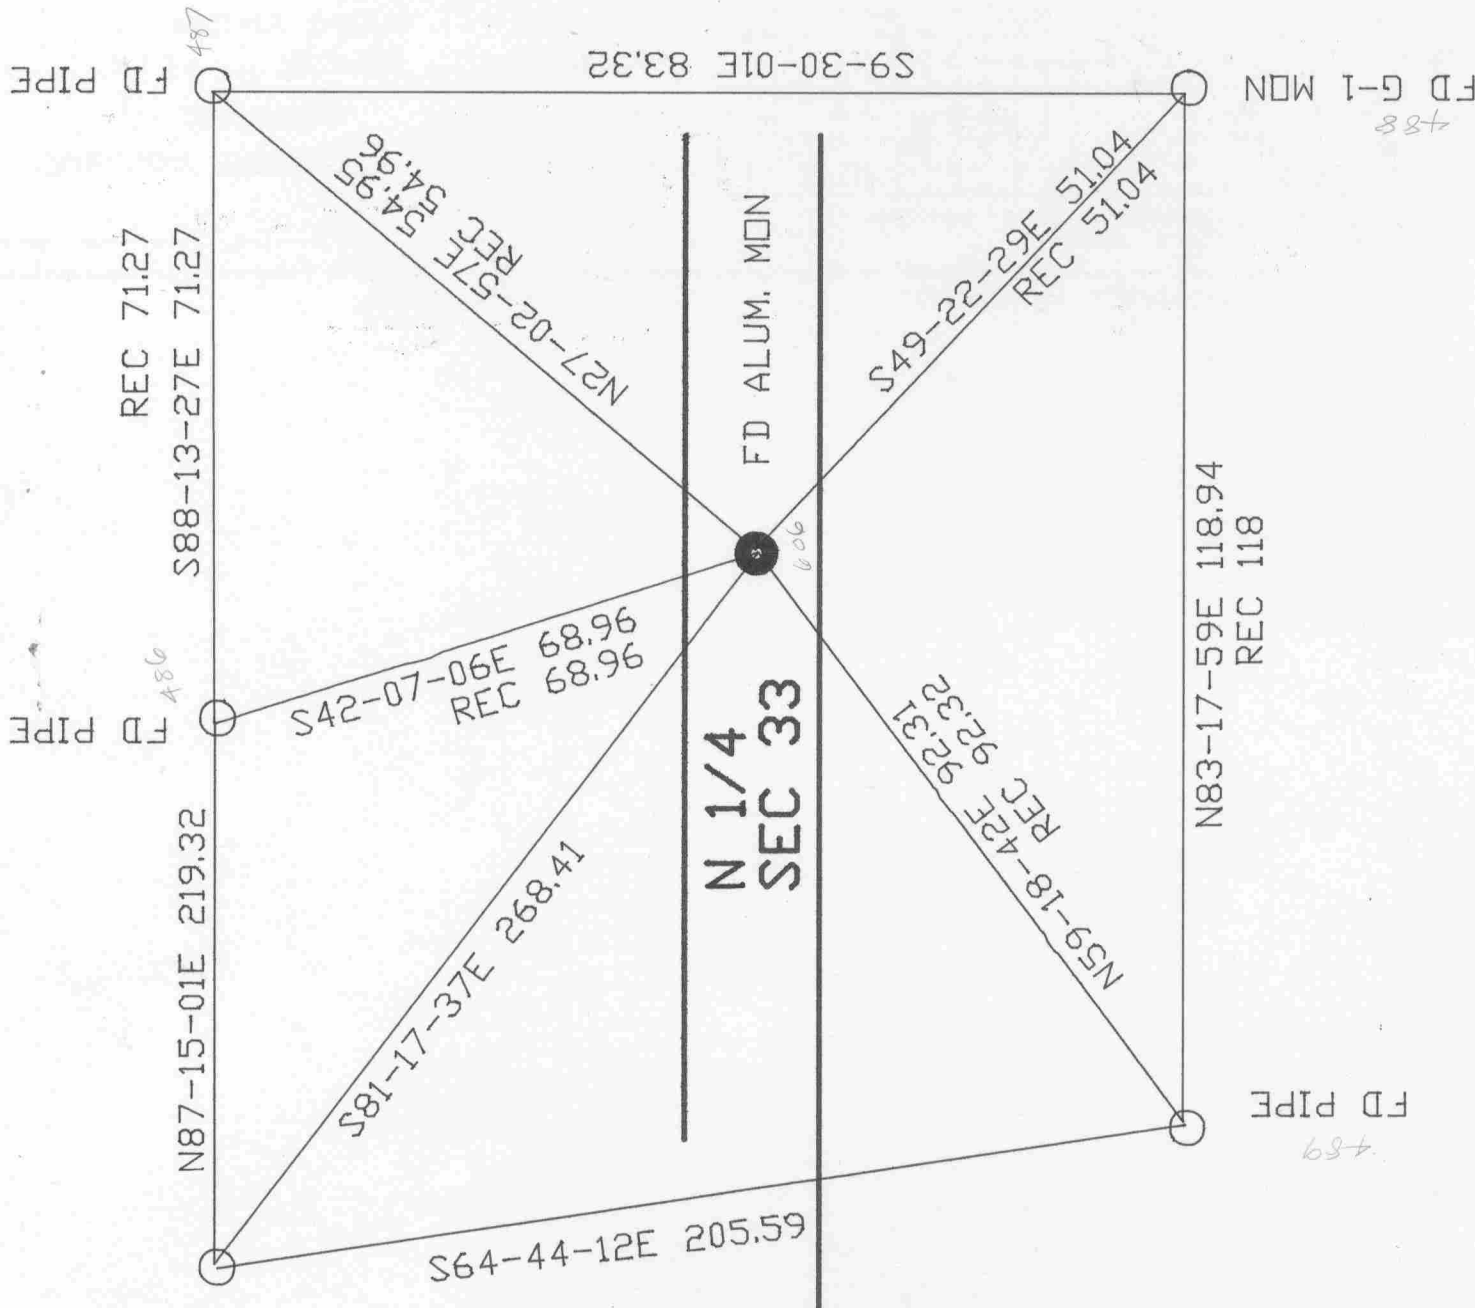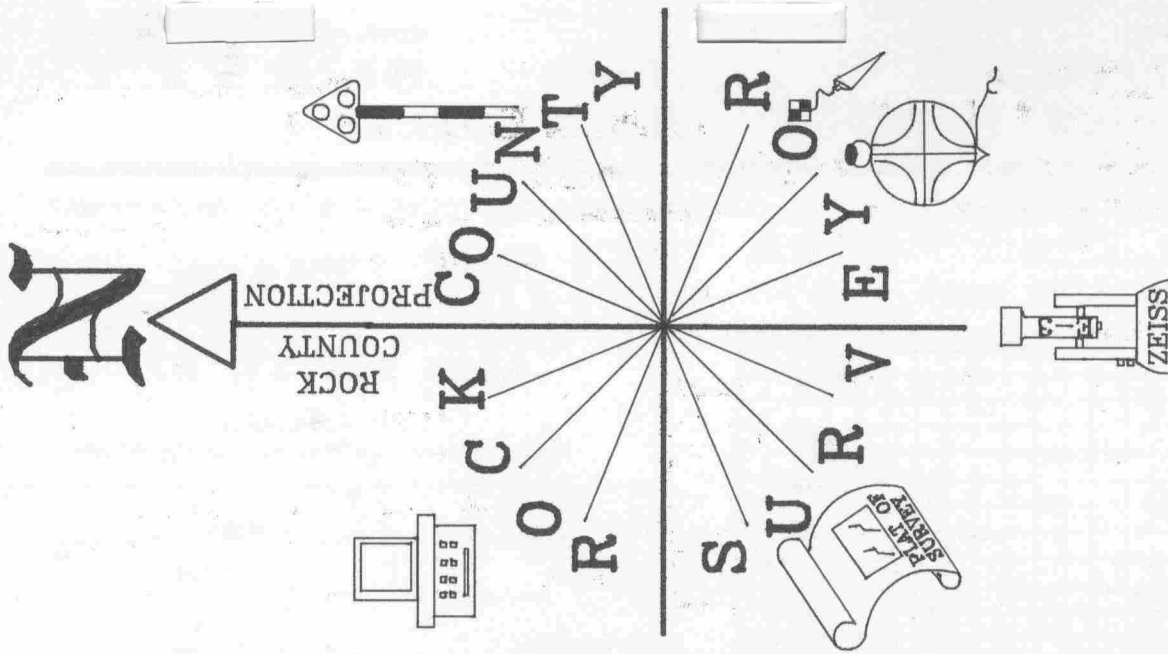

STA 3147
WI DOT DISK
ON REROD. GPS

STH 81

N 1/4
SEC 33

FD ALUM. MON

Donald Barnes
OCT 16, 1998

V-11