U.S.


LAND PUBLIC SURVEY MONUMENT RECORD

For Public Land Survey Corners in:

WI ADMINISTRATIVE CODE A-E 7.08 REQUIREMENT

T. 3N., R. ___E

CORNER CODE INDEX

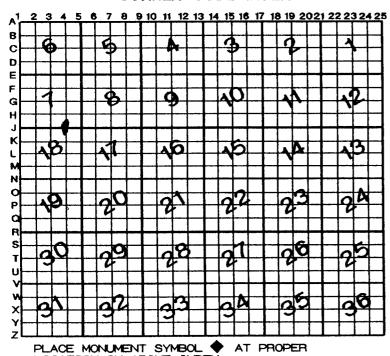

CENTER ROCK COUNTY WI

IF AVAILABLE ROCK COUNTY COORDINATES PERFERRED

North ____ Elev.

Hor. Datum _____ Vert. Datum

LATITUDE

LONGITUTE


GPS (X) ___ TRAVERSE (X) _

BASED ON THE FOLLOWING CONTROL:

♦CORNER MONUMENT

O WITNESS MONUMENT

N 1/16th COR OF NE 1/4 SEC 18

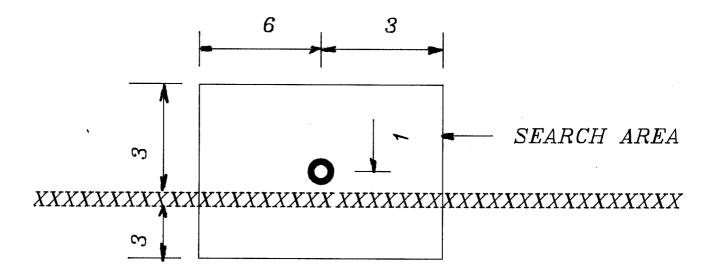

FB #2 PG 29

COMPUTED MID POINT & ON LINE WITH N 1/4 COR & NE CORNERS

		1			29	
FIELD	воок		PAGE	#	67	

SHOW A PLAN VIEW DRAWING DEPICTING THE CORNER MONUMENT AND SURROUNDING PHYSICAL FEATURES, INCLUDING THE EXCAVATION AREA AND DEPTH.

PLANNING & ZONING COMMITTEE ADOPTED THE ABOVE FORM ON 12/2/1982

ÿ BEARINGS ARE

(a)

CE2542

(B) Describe any record evidence, monument evidence, occupational evidence, testimonial evidence or any other material evidence you considered, and whether the monument was found or placed.

1876 RUGER VOL 2 PG 218 FOUND HH STONE AT COR PUT ON TOP OF IT LARGE HH STONE & SURROUNDED WITH SMALLER STONES. 1323.96 VAR 6-24 TO NE AND N 1/4 CORNERS OF SEC 18.

FOUND 5 VERY LARGE HARD HEADS 1' WEST OF COMPUTED POSITION. ENTIRE AREA HAS A LOT OF HARDHEADS. WAS NOT ABLE TO DETERMINE IF ANY OF THOSE WERE PLACED BY RUGER.

- C) Was the corner restored through acceptance of (1) an obliterated evidence location, or, (2) a found perpetuated location?
- D) Describe any material discrepancy between the location of the corner as restored or reestablished and the location of that corner as previously restored or reestablished by distance and direction. Show the discrepancy on the plan view drawing under (a), above. Show the distances between the corner as previously restored or reestablished and (1) the corner as restored or reestablished, and (2) to at least 4 of the witness monuments shown on the drawing in (a), above.
- (E) Was the corner reestablished through lost corner proportionate methods? If so, show the method, including the directions and distances to other public land survey corners used as evidence or used for proportioning the corner location.

I, Donald Barnes, hereby certify that the corner location as identified by the corner code index was determined by me under by direction and control and that this U.S. Public Land Survey Monument Record is correct and complete to the best of my knowledge and belief.

Junel Paines

Number of included sheets ____

emboss