

# U.S. PUBLIC LAND SURVEY MONUMENT RECORD


For Public Land Survey Corners in the  
T. 4 N., R. 13 E.

## CORNER CODE INDEX

	1	2	3	4	5	6	7	8	9	10	11	12	13	14	15	16	17	18	19	20	21	22	23	24	25
A																									
B																									
C	6																								
D		5																							
E			4																						
F				3																					
G					2																				
H																									
I																									
J																									
K																									
L																									
M																									
N																									
O																									
P																									
Q																									
R																									
S																									
T																									
U																									
V																									
W																									
X																									
Y																									
Z																									

PLACE MONUMENT SYMBOL (◆) AT PROPER LOCATION ON ABOVE INDEX

### EXAMPLE

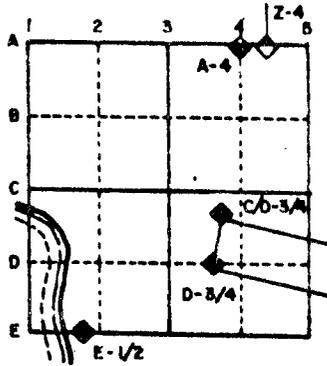

MILTON TWP  
ROCK COUNTY WI

### IF AVAILABLE STATE PLANE COORDINATES

North (Y) \_\_\_\_\_ Eleve. (Z) \_\_\_\_\_  
 East (X) \_\_\_\_\_ Zone \_\_\_\_\_  
 Hor. Datum \_\_\_\_\_ Vert. Datum \_\_\_\_\_

a.)


◆ CORNER MONUMENT

○ WITNESS MONUMENT

BEARINGS ARE BASED ON:

DUG 5' DEEP AND FOUND NO TOP SOIL. ALL THAT I FOUND WAS PURE SAND. AREA WAS PROBABLY EXCAVATED DURING PREVIOUS ROAD CONSTRUCTION

MONUMENT WAS REFERENCED BY D.D.T. CONSULTANTS.

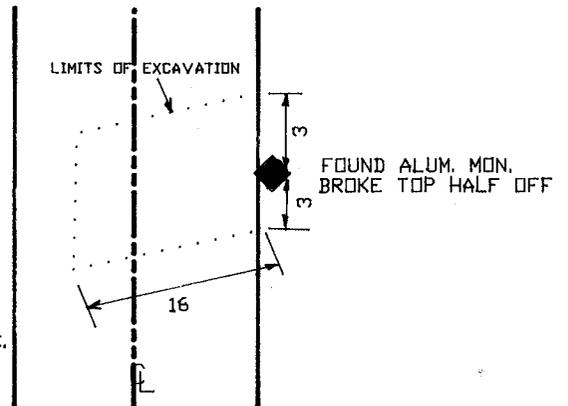

S.T.H. 26

MICROFILMED

SHEET 1 OF 1

CORNER CODE: E 19

FIELD # 2 P. 56  
BOOK

(B) Describe any record evidence, monument evidence, occupational evidence, testimonial evidence or any other material evidence you considered, and whether the monument was found or placed.

18?? VOL 6 PG 331 TERRITORIAL ROAD RECORDS. SHOWS CORNER 165' WEST OF CENTER OF PAVEMENT.

1871 RUGERS REMONUMENTATION NOTES. EAST ON NORTH LINE NW 1/4 SEC 11 ON A VAR 3-25 OFFSET 15 LKS AT 2659.8 INTERSECTED 1/4 LINE 18 LKS N OF 1/4 COR. FOUND OLD STAKE & LIME STONE AT CORNER ALSO FOUND WHERE STUMP OF BEARING TREE HAD BEEN DUG UP. CORRECTED VAR 3-22 PLACED CUT LIMESTONE. EAST ON N LINE NE 1/4 ON A VAR 3-30 OFFSET NORTH 10 LKS SOUTH 30 LKS AT 2659.8-0 INTERSECTED EAST BOUNDARY LINE 210 LKS SOUTH OF COR. FOUND OLD STAKE AT COR ALSO FD STUMP OF SW BT & WHERE STUMP OF NE B.T. HAD BEEN DUG UP. 2659.8 TO NW COR SEC 11 & 2659.8' TO NE COR SEC 11.

1892 BLEEDHORN VOL 2 PG 471 SHOWS MONUMENT & 2659.8' TO NW CORNER OF SEC 11. USED CORNER TO SUBDIVIDE SECTION 11. HE SHOWS A DISTANCE OF 2673.66 TO THE W 1/4 COR OF SEC 11. SUNNY RECORDED DISTANCE IS 2689.70. THE COMPUTED DISTANCE TO THE INTERSECTION OF THE 1/4 LINES IS

1976 BARNES VOL 5 PG 175 DUG AND FOUND NOTHING. DECLARED CORNER LOST & PLACED BY SINGLE PROPORTIONATE MEASUREMENT. 2644.17' TO NW CORNER OF SEC 11 & 2644.17 TO NE CORNER OF SEC 11.

WHILE STH 26 WAS BEING RECONSTRUCTED, I DUG A VERY LARGE HOLE ON LINE WITH THE E/W FENCES AND WEST OF THE PREVIOUS EXCAVATION. I DID NOT FIND THE CUT LIMESTONE. UNDER THE PAVEMENT THERE WAS NO TOP SOIL. THERE WAS PURE SAND IN THE ENTIRE HOLE.


C) Was the corner restored through acceptance of (1) an obliterated evidence location, or, (2) a found perpetuated location?

ACCEPTED CORNER THAT I PLACED IN 1976.

D) Describe any material discrepancy between the location of the corner as restored or reestablished and the location of that corner as previously restored or reestablished by distance and direction. Show the discrepancy on the plan view drawing under (a), above. Show the distances between the corner as previously restored or reestablished and (1) the corner as restored or reestablished, and (2) to at least 4 of the witness monuments shown on the drawing in (a), above.

(E) Was the corner reestablished through lost corner proportionate methods? If so, show the method, including the directions and distances to other public land survey corners used as evidence or used for proportioning the corner location.

I, Donald Barnes, hereby certify that the corner points as identified by the corner code index were, in a field survey on, Aug / 1989, established, re-established, monumented, re-monumented, recovered or restored as expressed below and in conformance with the regulations and rules as required in the current manual of survey instructions of the United States Department of Interior, Bureau of Land Management.

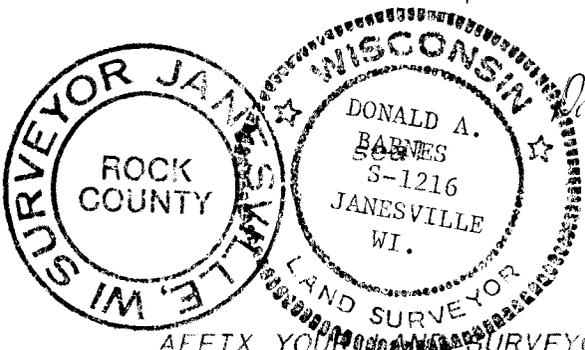

AFFIX YOUR SURVEYOR SEAL

COUNTY SURVEYOR FILING DATA  
Date of computer entry \_\_\_\_\_  
Date microfilmed \_\_\_\_\_  
Number of included sheets E-19  
CORNER CODE

*Donald Barnes*