

U.S. PUBLIC LAND SURVEY MONUMENT RECORD


For Public Land Survey Corners in the
T. 3 N., R. 11 E.

CORNER CODE INDEX

	1	2	3	4	5	6	7	8	9	10	11	12	13	14	15	16	17	18	19	20	21	22	23	24	25
A																									
B																									
C	6	5	4	3	2																				
D																									
E																									
F																									
G	7	8	9	10	11	12																			
H																									
I																									
J																									
K	18	17	16	15	14	13																			
L																									
M																									
N																									
O																									
P	19	20	21	22	23	24																			
Q																									
R																									
S																									
T	30	29	28	27	26	25																			
U																									
V																									
W																									
X																									
Y																									
Z																									

PLACE MONUMENT SYMBOL (◆) AT PROPER LOCATION ON ABOVE INDEX

EXAMPLE

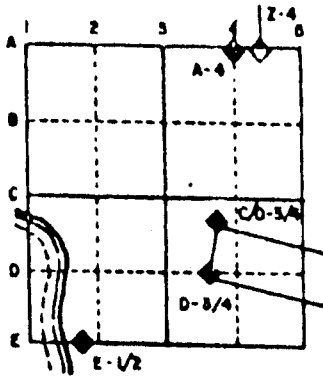


CENTER TWP
ROCK COUNTY WI

IF AVAILABLE
STATE PLANE COORDINATES

North (Y) _____ Eleve. (Z) _____
 East (X) _____ Zone _____
 Hor. Datum _____ Vert. Datum _____

◆ CORNER MONUMENT ○ WITNESS MONUMENT

BEARINGS ARE BASED ON: ASSUMED

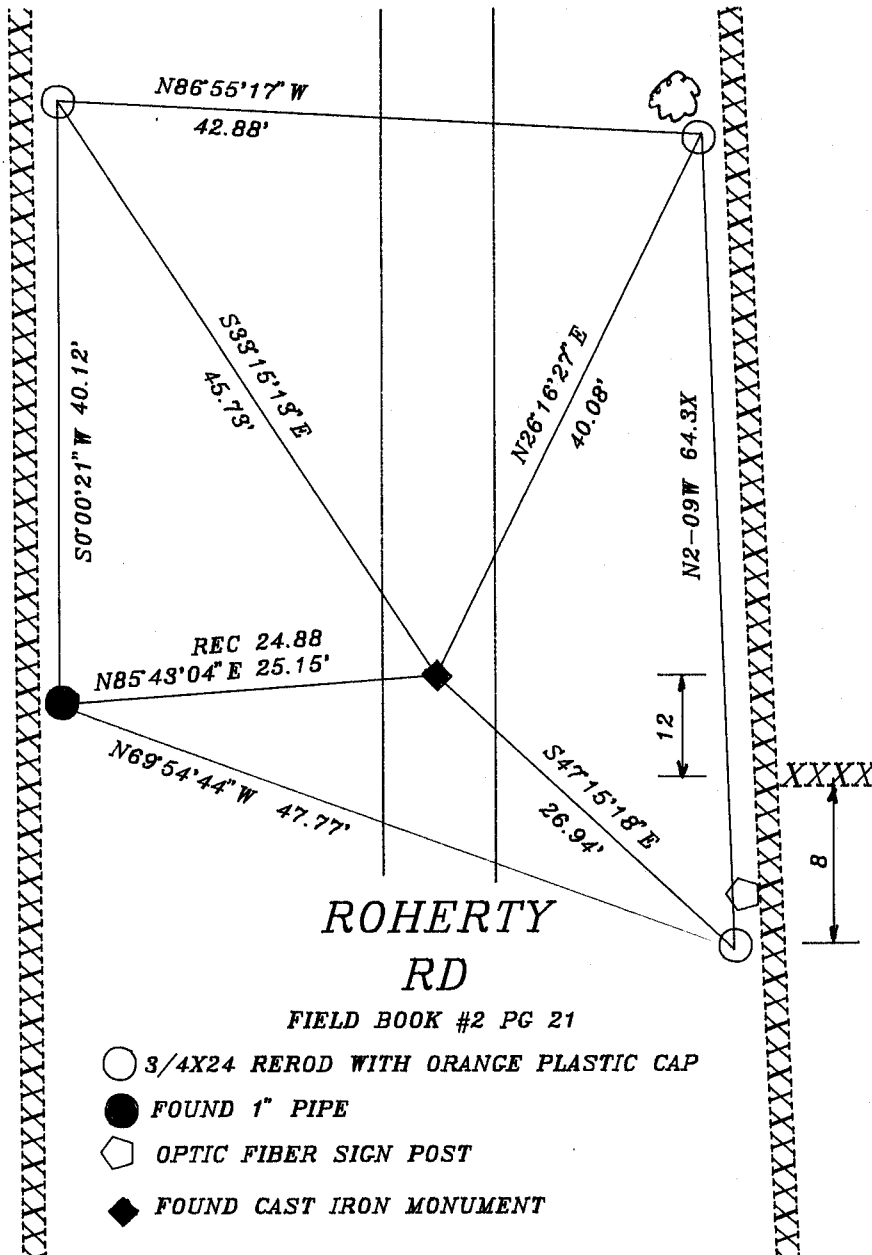

**ROHERTY
RD**

FIELD BOOK #2 PG 21

- 3/4X24 REROD WITH ORANGE PLASTIC CAP
- FOUND 1" PIPE
- ◊ OPTIC FIBER SIGN POST
- ◆ FOUND CAST IRON MONUMENT

MICROFILMED

SHEET ___ OF ___

CORNER CODE: P 17

(B) Describe any record evidence, monument evidence, occupational evidence, testimonial evidence or any other material evidence you considered, and whether the monument was found or placed.

- 1905 RUGER VOL 5 PG 324 THE CORNER IS IN CENTER OF N/S ROAD AND IN LINE WITH FENCE TO EAST. SET LIMESTONE 16X9X4 SURROUNDED BY 4 WHITE BRICKS. CALLS FOR THE FOLLOWING: 2657.66 VAR 4- 55 TO NE CORNER, 2657.66 VAR 4-36 TO SE CORNER, AND 2695.77 TO CENTER OF SECTION 22.
- 1962 SHIMEALL MAP#767 CALLS FOR STONE.
- 1965 CHENEY MAP #13587 FOUND 2 IRON STAKES AT CORNER.
- 1966 CHENEY MAP#13586 FOUND IRON STAKE.
- 1968 BATTERMAN JR. VOL 4 PG 381 FOUND LIMESTONE. REFERENCED WITH SPIKE 3' WEST AND 3' SOUTH. FOUND LIMESTONE 3X6X2 SURROUNDED BY 4 HARDHEADS AT 1/16TH CORNER TO THE WEST.
- 1971 LEE VOL 4 PG 520 FOUND PK SET BY SHIMEALL OVER 6X12X18 LIMESTONE WITH BRICK ONE SIDE. SET HARRISON MONUMENT AND REFERENCED SAME.
- 1975 COMBS CSM VOL 4 PG 259 FOUND MONUMENT BUT DID NOT DESCRIBE IT.
- 1975 LEE VOL 5 PG 151 FOUND CAST IRON MONUMENT.
- 1978 WOODMAN CSM VOL 8 PG 233 CALLS FOR 1" PIPE.
- 1985 COMBS CSM VOL 12 PG 115 USED MONUMENT BUT DID NOT STATE WHAT IT WAS.
- 1987 COMBS CSM VOL 13 PG 82 USED MONUMENT BUT DID NOT STATE WHAT IT WAS.
- 1990 N. LEE MAP #2660 FOUND CAST IRON MONUMENT. CALLS FOR 2694.42 TO IRON PIPE AT CENTER OF SECTION 22 AND 2658.75 TO NE CORNER OF SECTION 22.

FOUND CAST IRON MONUMENT.


C) Was the corner restored through acceptance of (1) an obliterated evidence location, or, (2) a found perpetuated location?

ACCEPTED FOUND MONUMENT.

D) Describe any material discrepancy between the location of the corner as restored or reestablished and the location of that corner as previously restored or reestablished by distance and direction. Show the discrepancy on the plan view drawing under (a), above. Show the distances between the corner as previously restored or reestablished and (1) the corner as restored or reestablished, and (2) to at least 4 of the witness monuments shown on the drawing in (a), above.

(E) Was the corner reestablished through lost corner proportionate methods? If so, show the method, including the directions and distances to other public land survey corners used as evidence or used for proportioning the corner location.

I, Donald Barnes, hereby certify that the corner points as identified by the corner code index were, in a field survey on, October 25, 1990, established, re-established, monumented, re-monumented, recovered or restored as expressed below and in conformance with the regulations and rules as required in the current manual of survey instructions of the United States Department of Interior, Bureau of Land Management.

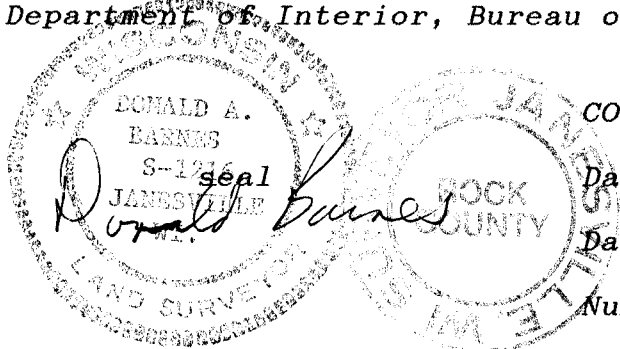

COUNTY SURVEYOR FILING DATA

Date of computer entry _____

Date microfilmed _____

Number of included sheets _____

CORNER CODE

AFFIX YOUR LAND SURVEYOR SEAL