U.S. PUBLIC LAND SURVEY MONUMENT RECORD

For Public Land Survey Corners in the T. 3N, R. // E CORNER CODE INDEX EXAMPLE 2 3 4 CENTER TWP ROCK COUNTY -- 15-20 IF AVAILABLE STATE PLANE COORDINATES 27 -- 28 26 North (Y) 246, 064, 68 Eleve. (Z) East (X) 2, 220, 606, 2/ Zone - 33 Hor. Datum Vert. Datum PLACE MONUMENT SYMBOL (4) AT PROPER DOT CONTROL USING LOCATION ON ABOVE INDEX O WITNESS MONUMENT FOUND I'PIPE CORNER MONUMENT (a.) N89-09-04E 42,88 REC 49.92 ∞ RERO D N 86 - 20-24 E SITH 588-56-4+ W 11

FIELD BOOK 3 PAGE # 25

2.57

SHOW A PLAN VIEW DRAWING DEPICTING THE CORNER MONUMENT AND SURROUNDING PHYSICAL FEATURES, INCLUDING THE EXCAVATION AREA AND DEPTH. THE CORNER MONUMENT SHALL HAVE THE FOLLOWING CHARACTERISTICS: I) HAVE AT LEAST TWO PREDETERMINED BREAK-OFF POINTS. 2) IF BROKEN, LEAVE A PERMANENTLY MAGNETIZED REMNANT AT THE ORIGINAL POINT. 3) MUST BE EXTENDABLE. 4) THE CAP IS INSCRIBED. ROCK COUNTY SURVEY MONUMENT - PENALTY FOR DISTURBING MARKER. 5) OR AN EXISTING CUT LIMESTONE. AN IRON PIPE I 2 40" (MINIMUM) MAY BE USED IN AREAS WHERE GHOUND WATER IS WITHIN ONE FOOT OF THE SURFACE. IF THE CORNER IS OCCUPIED BY AN IMPROVEMENT (MANHOLE, BURIED CABLE, ETC.) ANY DURABLE, DISTINCT MONUMENT MAY BE USED. CORNERS SHALL BE REFERENCED WITH AT LEAST. 4 DURABLE WITNESS MONUMENTS. WITNESS MONUMENTS SHALL BE MADE OF CONCRETE, NATURAL STONE, IRON OR OTHER EQUALLY DURABLE MATERIAL, EXCEPT WOOD. DESCRIBE THE CORNER AND THE WITNESS MONUMENTS.

32 85

32,84

N86-28-49E

REC

CORNER CODE:

215

85.98


- (b.) Describe any record evidence, monument evidence, occupational evidence, testimonial evidence or any other material evidence you considered, and whether the monument was found or placed.
 - 1866 LOCKE REMONUMENTATION INTERSECTED 1/4 LINE FOR SEC 34 TOWN 3 N AT CORNER. FOUND OLD STAKE IN CENTER OF HIGHWAY AND IN LINE OF FENCES RUNNING NORTH AND SOUTH. SET 1/4 CORNER OF SECTION 3 13.20 EAST OF SOUTH QUARTER CORNER THE SECTION CORNERS WEST BEING LAST. CALLS FOR A DISTANCE OF 2658.48 TO THE SW CORNER AND 2668.05 TO THE SE CORNER. PLACED CUT LIMESTONE AT THE NORTH QUARTER CORNER. (POSSIBLE AT THE SOUTH QUARTER CORNER)
 - 1933 SUNNY VOL 3 PG 235 SHOWS THAT HE PLACED THE NORTH QUARTER CORNER OF SECTION 3. HE SHOWS THAT THE S 1/4 QUARTER OF
 - (c.) Was the corner restored through acceptance or (1) an obliterated evidence location?

YES OBLITERATED EVIDENCE PLACED CORNER ON LINE WITH NYA COR 3 AND NW CORNER 3 AT RECORD DISTANCE.

(d.) Describe any material discrepancy between the location of the corner as restored or reestablished and the location of that corner as previously restored or reestablished by distance and direction. Show the discrepancy on the plan view drawing under (a), above. Show the distances between the corner as previously restored or reestablished and (1) the corner as restored or reestablished, and (2) to at least 4 of the witness monuments shown on the drawing in (a), above.

(e) Was the corner reestablished through lost corner proportionate methods? If so, show the method, including the directions and distances to other public land survey corners used as evidence or used for proportioning in determining the corner location.

I, Description of the United States Department of Interior, Bureau of Land Management.

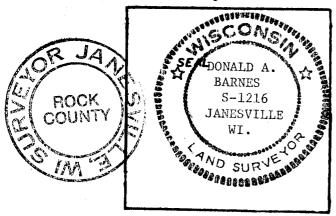

COUNTY SURVEYOR FILING DATA	. •
Date of Computer Entry	•
Date Received	
Date Microfilmed	
Treasurer's Receipt No.	
Number of Included Sheets	
	COPNED

AFFIX YOUR LAND SURVEYOR SEAL. CODE