
e.)


BEARINGS ARE BASED ON : ASSUMED

U.S. PUBLIC LAND SURVEY MONUMENT RECORD

For Public Land Survey Corners in the T. 3 N., R. // E.

CORNER CODE INDEX

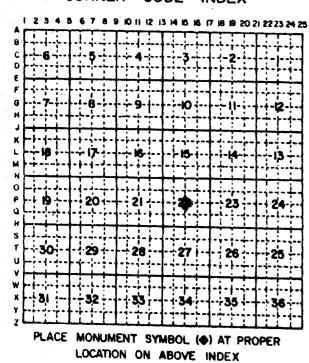

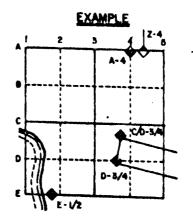

CENTER ROCK COUNTY


Vert. Datum

IF AVAILABLE STATE PLANE COURDINATES

North (Y)	Eleve. (Z)
East (X)	Zone
Hor. Datum	Vert Datum

CORNER MONUMENT 1" PIPE

O WITNESS MONUMENT

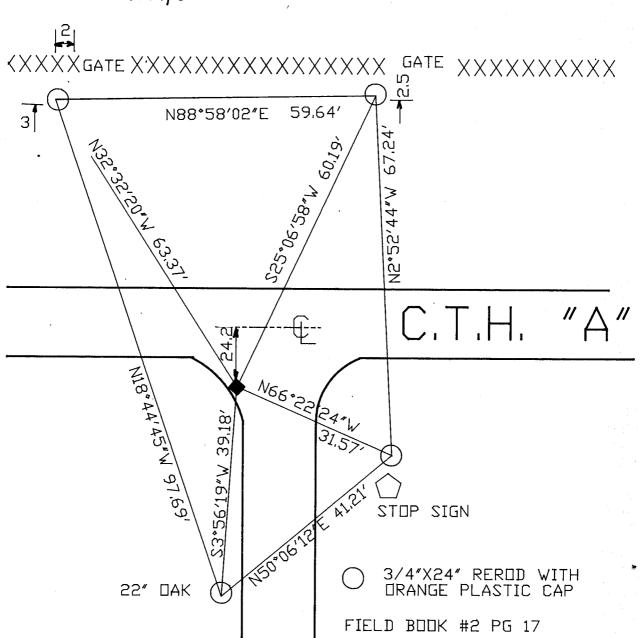

MICROFILMED

SHEET___ OF_

CORNER CODE : 15

Describe any record evidence, monument evidence, occupational evidence, testimonial evidence or any other material evidence you considered, and whether the monument was found or placed.

1905 RUGER VOL 5 PG 324 PLACED A TRIANGULAR LIMESTONE 14X13X3 SURROUNDED BY 4 WHITE BRICKS. SHOWS THE FOLLOWING DISTANCES:

CENTER TO N 1/4 CORNER 2655.92

CENTER TO E 1/4 CORNER 2695.61

CENTER TO W 1/4 CORNER 2674.32

CENTER TO S 1/4 CORNER 2670.36

1968 SHIMEALL VOL 4 PG 381 PLACED 1" PIPE. SHOWS A PIPE AT THE S 1/4 CORNER, LIMESTONE AT THE E 1/4 CORNER, HH AT THE N 1/4 CORNER, AND A LIMESTONE 3X6X2 SURROUNDED BY 4 HH AT THE S 1/16TH CORNER OF THE NE 1/4 OF SECTION 22.

1968 SHIMEALL PLAT OF SURVEY. SHOWS THE FOLLOWING DISTANCES AND ANGLES:

CENTER TO N 1/4 CORNER 2655.7 ANGLE N1/4-CENTER-E1/4 89-44-30 ANGLE NW-N1/4-CENTER 89-47-30 NW TO N 1/4 CORNER 2678.56

FOUND 1" PIPE 0.6' DEEP AND 24.2 SOUTH THE E/W CENTER OF PAVEMENT ON LINE WITH THE WEST EDGE OF THE PAVEMENT THAT IS PROJECTED FROM THE SOUTH.

Was the corner restored through acceptance of (1) an obliterated evidence location, or, (2) a found perpetuated location?

DID NOT ACCEPT NOR REJECT THE PIPE. PERPETUATED FOUND PIPE.

- Describe any material discrepancy between the location of the corner as restored or reestablished and the location of that corner as previously restored or reestablished by distance and direction. Show the discrepancy on the plan view drawing under (a), above. Show the distances between the corner as previously restored or reestablished and (1) the corner as restored or reestablished, and (2) to at least 4 of the witness monuments shown on the drawing in (a), above.
- Was the corner reestablished through lost corner proportionate methods? If so, show the method, including the directions and distances to other public land survey corners used as evidence or used for proportioning the corner location.
- I, Donald Barnes, hereby certify that the corner points as identified by the corner code index were, in a field survey on, September 25,1990, established, re-established, monumented, remonumented, recovered or restored as expressed below and in conformance with the regulations and rules as required in the current manual of survey instructions of the United States

Department of Interior, Bureau of Land Management.

COUNTY SURVEYOR FILI DONALD A. JANESVILLE AFFIX YOUR LAND SURVEYOR SEAL NO SURVE

COUNTY SURVEYOR FILING DATA

Date of computer entry____

Date microfilmed

Number of included sheets

CORNER CODE