

U.S. PUBLIC LAND SURVEY MONUMENT RECORD

For Public Land Survey Corners In:
T. 4 N. R. 12 E. 4th P.M.
CORNER CODE INDEX

WI ADMINISTRATIVE CODE A-E 7.08 REQUIREMENT
REV 10/23/2004 USMONREC.DWG

A	1	2	3	4	5	6	7	8	9	10	11	12	13	14	15	16	17	18	19	20	21	22	23	24	25	A
B																										B
C	6						5					4					3				2				1	C
D																										D
E																										E
F																										F
G	7						8					9					10				11				12	G
H																										H
J																										J
K																										K
L	18						17					16					15				14				13	L
M																										M
N																										N
O																										O
P	19						20					21					22				23				24	P
Q																										Q
R																										R
S																										S
T	30						29					28					27				26				25	T
U																										U
V																										V
W																										W
X	31						32					33					34				35				36	X
Y																										Y
Z																										Z

PLACE MONUMENT SYMBOL AT PROPER LOCATION ON ABOVE INDEX

FULTON TWP
ROCK COUNTY WI

IF AVAILABLE
ROCK COUNTY COORDINATES PREFERRED

North _____ Elev. _____

East _____

Hor. Datum _____ Vert. Datum _____

LATITUDE _____ ELLIPS. HT. _____

LONGITUDE _____

NAD83(91) _____ NETWORK ADJ. YR _____

GPS (X) _____ TRAVERSE (X) _____

BASED ON THE FOLLOWING CONTROL:

CORNER MONUMENT

WITNESS MONUMENT

BEARINGS ARE BASED ON:


FIELD BOOK _____ PAGE # _____

SHEET 1 OF 1

SHOW A PLAN VIEW DRAWING DEPICTING THE CORNER MONUMENT AND SURROUNDING PHYSICAL FEATURES, INCLUDING THE EXCAVATION AREA AND DEPTH.

PLANNING & ZONING COMMITTEE ADOPTED THIS FORM ON 12/2/1982



CORNER CODE D-1

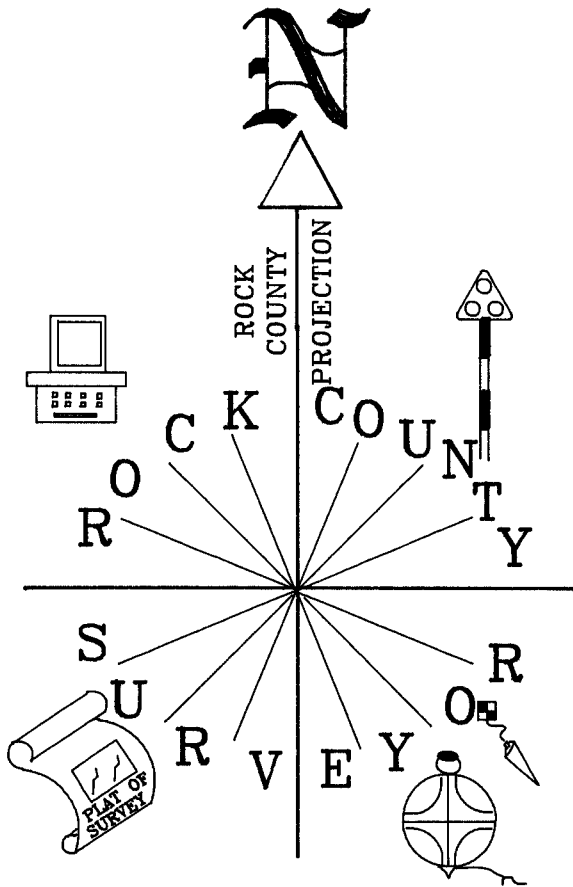

W 1/16TH COR
 OF SW 1/4 OF
 SEC 6 FULTON
 TWP T4N R12E

OBSERVATION SHEET #2521

○ FD PIPE

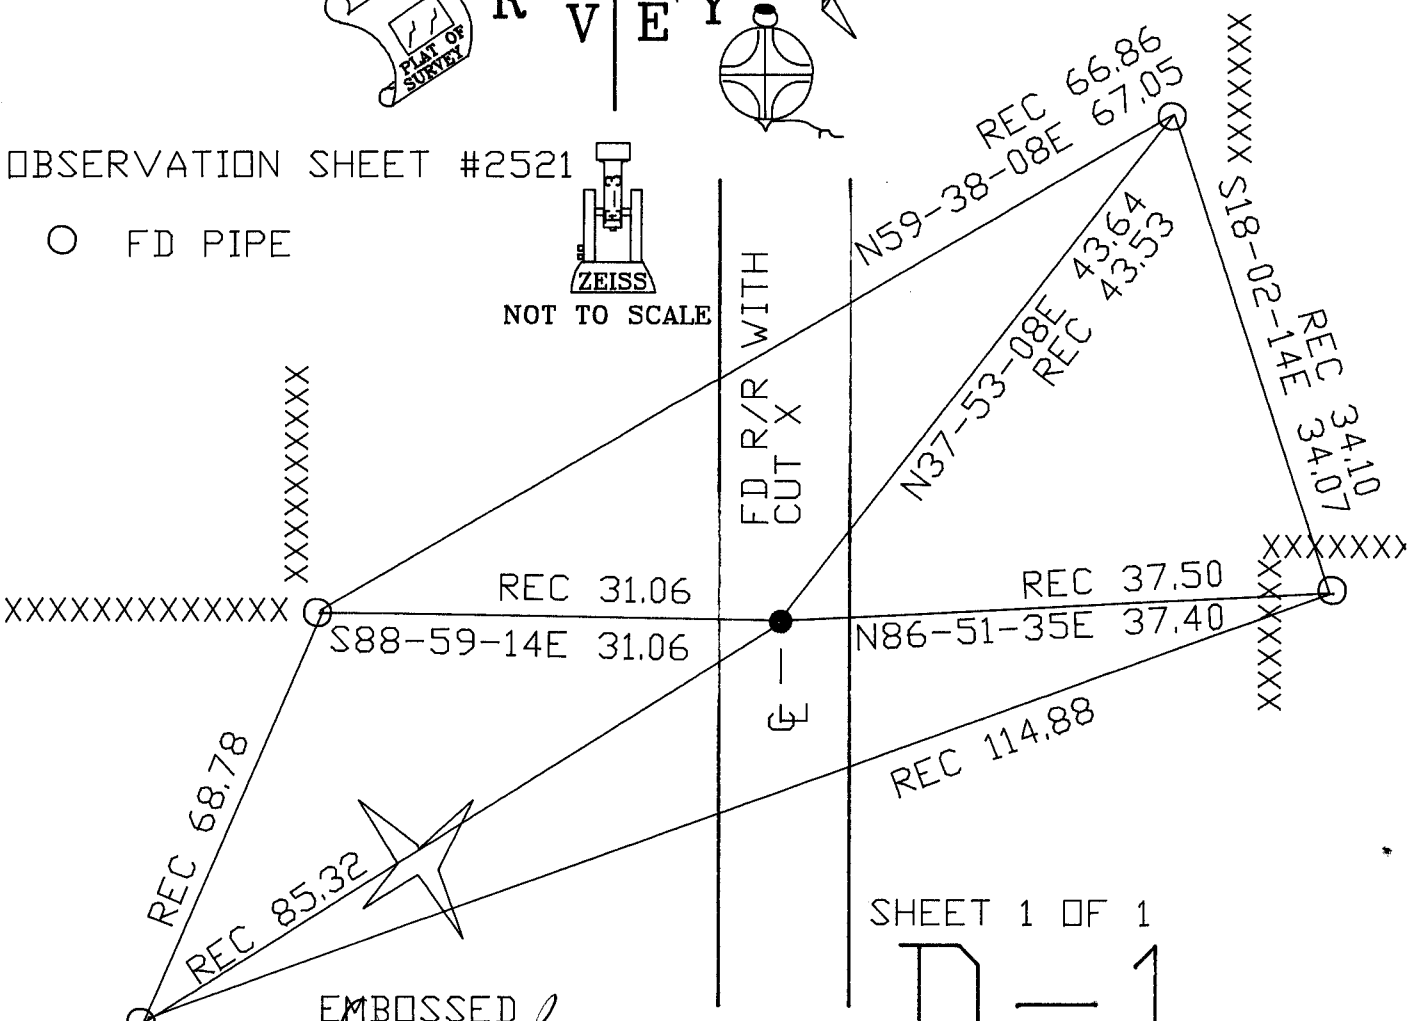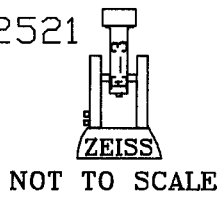

SHEET 1 OF 1

D-1

EMBOSSED SEAL
Donald Barnes
 May 8 2006