

For Public Land Survey Corners in the T. \rightarrow N., R. \swarrow E.

CORNER CODE INDEX

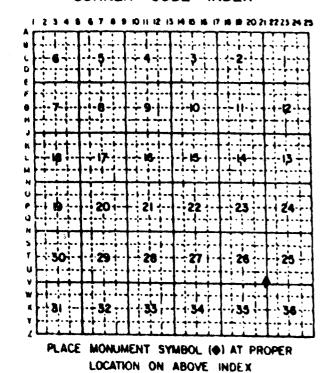

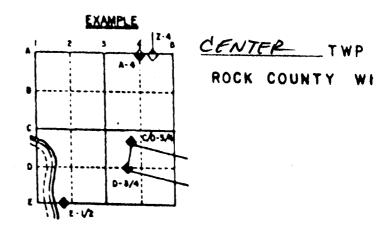

IF AVAILABLE
STATE PLANE COURDINATES

North (Y)	Eleve. (2)
East (X)	Zone
Hor. Datum	Vert. Datum

CORNER MONUMENT

O WITNESS MONUMENT



.)

CODNED CODE:

- (B) Describe any record evidence, monument evidence, occupational evidence, testimonial evidence or any other material evidence you considered, and whether the monument was found or placed. FOUND ALUM. MON. WITH TOP BROKE OFF.
- C) Was the corner restored through acceptance of (1) an obliterated evidence location, or, (2) a found perpetuated location? ACCEPTED FOUND MONUMENT. ROAD CONSTRUCTION WILL DISTURB AREA.
- D) Describe any material discrepancy between the location of the corner as restored or reestablished and the location of that corner as previously restored or reestablished by distance and direction. Show the discrepancy on the plan view drawing under (a), above. Show the distances between the corner as previously restored or reestablished and (1) the corner as restored or reestablished, and (2) to at least 4 of the witness monuments shown on the drawing in (a), above.
- (E) Was the corner reestablished through lost corner proportionate methods? If so, show the method, including the directions and distances to other public land survey corners used as evidence or used for proportioning the corner location.

I, Donald Barnes, hereby certify that the corner points as identified by the corner code index were, in a field survey on, May 2, 1994, established, re-established, monumented, re-monumented, recovered or restored as expressed below and in conformance with the regulations and rules as required in the current manual of survey instructions of the United States Department of Interior, Bureau of Land Management.

Somel, 1994

COUNTY SURVEYOR FILING DATA

Date of computer entry_____

Date microfilmed _____

Number of included sheets 1_____

CORNER CODE

