
PUBLIC LAND SURVEY MONUMENT RECORD

WI ADMINISTRATIVE CODE A-É 7.08 REQUIREMENT For Public Land Survey Corners in: T. <u>≧ N.</u>, R. <u>//</u> E 4th P.M. CORNER CODE INDEX CENTER TWP ROCK COUNTY, WI IF AVAILABLE ROCK COUNTY COORDINATES PERFERRED E G North Elav. East Hor. Datum _____ Vert. Datum 0 LATITUDE ELLIPS. HT. PG LONGITUTE RST ELLIPS. DATUM _ COUNTY ___ LIST_ NAD83(91) _ TRAVERSE (X) _ GPS (X) BASED ON THE FOLLOWING CONTROL: PLACE MONUMENT SYMBOL LOCATION ON ABOVE INDEX

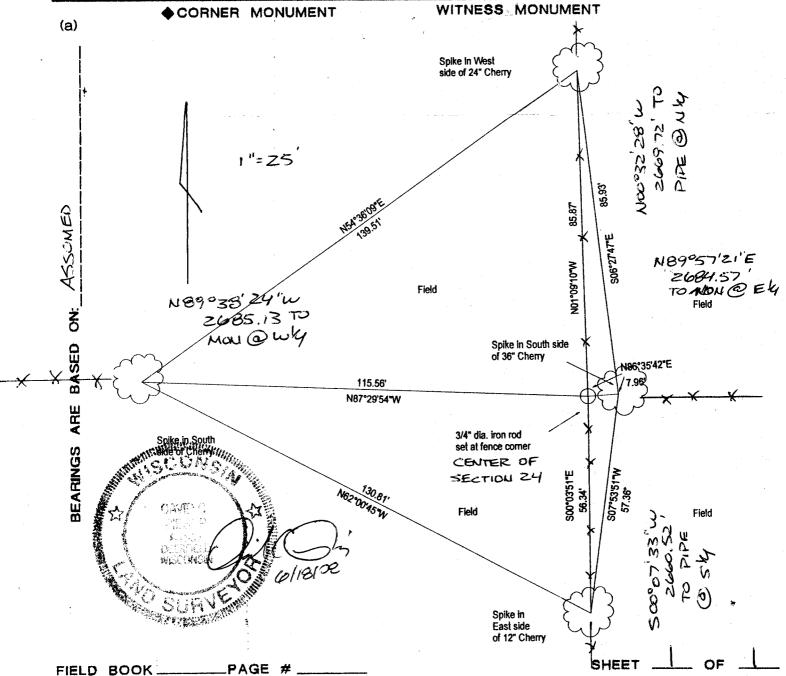

SHOW A PLAN VIEW DRAWING DEPICTING THE CORNER MONUMENT AND SURROUNDING PHYSICAL FEATURES, INCLUDING THE EXCAVATION AREA AND DEPTH.
PLANNING & ZONING COMMITTEE ADOPTED THE ABOVE FORM ON 12/2/1982

- Describe any record evidence, monument evidence, occupational evidence, testimonial evidence or any other material evidence you considered, and whether the monument was found or placed.

 I set a 34" dia rod at a very large and old fence corner. I accepted this corner as witness of 1857 sorry by Noseph Church, County Survey Record # 768. This location generally fits adjacent occupied fence lines and provider distances to the Church survey to the West and South 14 corners. A straight line intersection of the 14 lines falls N58°32'34'W, 18.22.
- Was the corner restored through acceptance of (1) an obliterated evidence location, or, (2) a found perpetuated location?

Accepted Fence Corner

Describe any material discrepancy between the location of the Corner as restored or reestablished and the location of that corner as previously restored or reestablished by distance and direction. Show the discrepancy on the plan view drawing under (a), above. Show the distances between the corner as previously restored or reestablished and (1) the corner as restored or reestablished, and (2) to at least 4 of the witness monuments shown on the drawing in (a), above.

AM

Was the corner reestablished through lost corner proportionate methods? If so, show the method, including the directions and distances to other public land survey corners used as evidence or used for proportioning the corner location.

NA

SCONS

seal

ALCO MANAGEMENT

I, DAUID RIESOP , hereby certify that the corner location as Identified by the corner code index was determined by me under by direction and control and that this U.S. Public Land Survey Monument Record is correct and complete to the best of my knowledge and belief.

6/18/08

Number of included sheets _

CORNER CODE P- 23 A-E 7.08 REQUIREMENT