
## U.S. PUBLIC LAND SURVEY MONUMENT RECORD

For Public Land Survey Corners in the T. 3. N., R. // E.

CORNER CODE INDEX

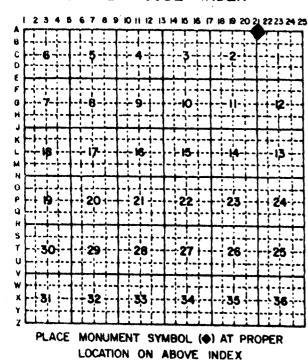

EXAMPLE

2 3 | Z-4 8 | CENTER TWP

ROCK COUNTY W

C D-8/4 | E-1/2

IF AVAILABLE STATE PLANE COORDINATES

North (Y) Eleve. (Z) Zone

Vert. Datum


Hor. Datum

e.)

CORNER MONUMENT

O WITNESS MONUMENT

BEARINGS ARE BASED ON : TRUE NORTH

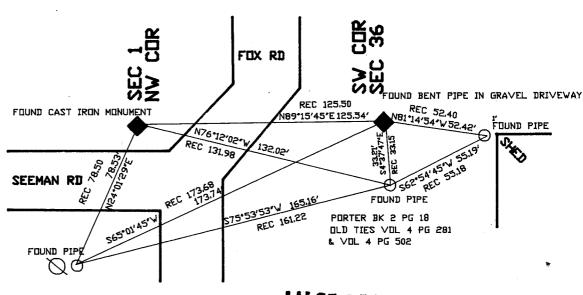

MICROFILMED

SHEET\_\_\_ OF\_\_\_

CORNER CODE: A 2/ 4

(B) Describe any record evidence, monument evidence, occupational evidence, testimonial evidence or any other material evidence you considered, and whether the monument was found or placed.

1833 ORIGINAL GOVERNMENT SURVEYOR SHOWS A JOG OF 125.4' WITH THE CENTER TOWNSHIP CORNER WEST OF THE PORTER TOWNSHIP CORNER.
MARKED BEARING TREES - BUR OAK 18 S27W 50.16' AND BUR OAK 14

S13E 27.72'


1864 LOCKE VOL 1 PG 216 FOUND STUMP OF BEARING TREE. SET HH  $15\mathrm{X}12\mathrm{X}7$  . Shows a Jog of 131.34 and a distance of 2541.00 to the west quarter corner and 2732.07 to north quarter corner OF SECTION 1.

FOUND STUMPS OF S.E. BEARING TREE AND 1883 RUGER VOL 2 PG 411 REMAINS OF STUMP OF S.W. BEARING TREE. DROVE STAKE.

1971 LEE VOL 4 PG 502. FOUND 3 HARD HEADS AND REPLACED WITH CAST IRON MONUMENT. SHOWS A JOG OF 125.50 WITH THE PORTER CORNER EAST OF THE CENTER CORNER. PLACED REFERENCE PIPES.

FOUND CAST IRON MONUMENT. CORNER IS 125.54' EAST OF THE CENTER TOWNSHIP CORNER.

- C) Was the corner restored through acceptance of (1) an obliterated evidence location, or, (2) a found perpetuated location? ACCEPTED FOUND PERPETUATED LOCATION.
- Describe any material discrepancy between the location of the corner as restored or reestablished and the location of that corner as previously restored or reestablished by distance and direction. Show the discrepancy on the plan view drawing under (a), above. Show the distances between the corner as previously restored or reestablished and (1) the corner as restored or reestablished, and (2) to at least 4 of the witness monuments shown on the drawing in (a), above.
- Was the corner reestablished through lost corner proportionate methods? If so, show the method, including the directions and distances to other public land survey corners used as evidence or used for proportioning the corner location.
- I, Donald Barnes, hereby certify that the corner points as identified by the corner code index were, in a field survey on, September 21, 1989, established, re-established, monumented, remonumented, recovered or restored as expressed below and in conformance with the regulations and rules as required in the current manual of survey instructions of the United States

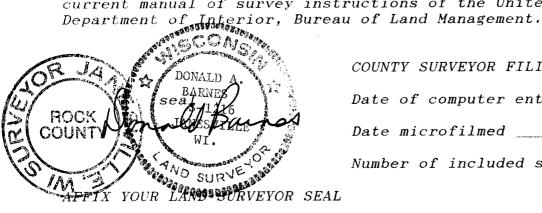

COUNTY SURVEYOR FILING DATA Date of computer entry\_\_\_ Date microfilmed \_ Number of included sheets CORNER CODE