

U.S. PUBLIC LAND SURVEY MONUMENT RECORD

For Public Land Survey Corners in the T.___N., R.__E.

CORNER CODE INDEX

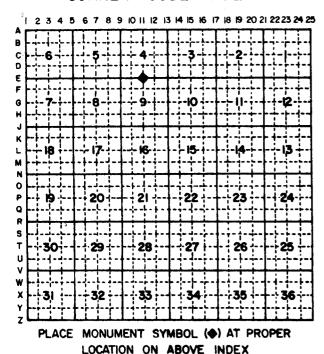

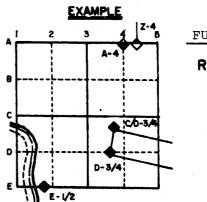

FULTON TWP

IF AVAILABLE STATE PLANE COORDINATES

North (Y) 304,907,36 Eleve. (Z)

East (X) Zone

Hor. Datum Vert. Datum

(a.)


BEARINGS ARE BASED ON

CORNER MONUMENT

Z" DIA. IRON PIPE
FOUND

O WITNESS MONUMENT

I" X Z4" IRON PIFE SET

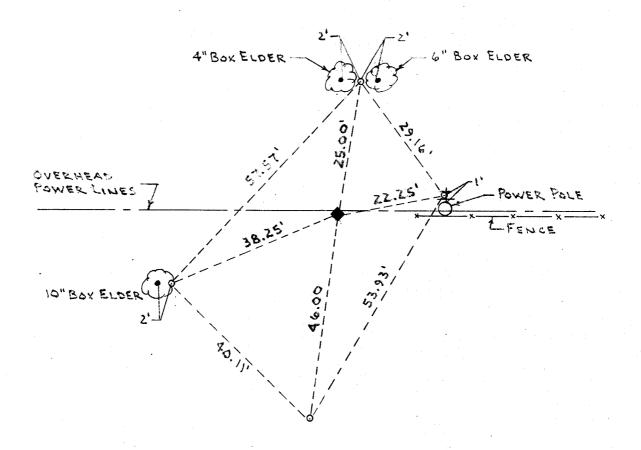

FIELD BOOK 644 PAGE # 69

SHOW A PLAN VIEW DRAWING DEPICTING THE CORNER MONUMENT AND SURROUNDING PHYSICAL FEATURES, INCLUDING THE EXCAVATION AREA

AND DEPTH. THE CORNER MONUMENT SHALL HAVE THE FOLLOWING CHARACTERISTICS: I) HAVE AT LEAST TWO PREDETERMINED BREAK-OFF
POINTS. 2) IF BROKEN, LEAVE A PERMANENTLY MAGNETIZED REMNANT AT THE ORIGINAL POINT. 3) MUST BE EXTENDABLE. 4) THE CAP
IS INSCRIBED: ROCK COUNTY SURVEY MONUMENT - PENALTY FOR DISTURBING MARKER. 5) OR AN EXISTING CUT LIMESTONE. AN IRON PIPE I ** X

4'0" (MINIMUM) MAY BE USED IN AREAS WHERE GROUND WATER IS WITHIN ONE FOOT OF THE SURFACE. IF THE CORNER IS OCCUPIED BY AN
IMPROVEMENT (MANHOLE, BURIED CABLE, ETC.) ANY DURABLE, DISTINCT MONUMENT MAY BE USED. CORNERS SHALL BE REFERENCED WITH AT
LEAST 4 DURABLE WITNESS MONUMENTS. WITNESS MONUMENTS SHALL BE MADE OF CONCRETE, NATURAL STONE, IRON OR OTHER EQUALLY DURABLE
MATERIAL, EXCEPT WOOD. DESCRIBE THE CORNER AND THE WITNESS MONUMENTS.

MICROFILMED

(b.) Describe any record evidence, monument evidence, occupational evidence, testimonial evidence or any other material evidence you considered, and whether the monument was found or placed.

Previous surveys referenced to the corner state that a 2" dia. iron pipe was found and used accepted as the North 1/4 corner of Section. There was no previous tie sheet for this corner at the County Surveyors office. A survey by B. J. Sunny, dated July 14 & 16, 1942 states that he set a 2" x 30" iron pipe at the North 1/4 when doing a survey of Outlot 185 of the Assessor's Plat of the City of Edgerton.

I accepted the iron pipe as representing the North 1/4 corner of Section 9 and tied as shown below.

(c.) Was the corner restored through acceptance of (1) an obliterated evidence location, or, (2) a found perpetuated location?

Through acceptance of a found perpetuated location.


(d.) Describe any material discrepancy between the location of the corner as restored or reestablished and the location of that corner as previously restored or reestablished by distance and direction. Show the discrepancy on the plan view drawing under (o), above. Show the distances between the corner as previously restored or reestablished and (1) the corner as restored or reestablished, and (2) to at least 4 of the witness monuments shown on the drawing in (c), above.

No. discrepancy known.

(e) Was the corner reestablished through lost corner proportionate methods? If so, show the method, including the directions and distances to other public land survey corners used as evidence or used for proportioning in determining the corner location.

No.

I, George A. Weir , hereby certify that the corner points as identified by the corner code index were, in a field survey on 2-19-85 , established, re-established, monumented, re-monumented, recovered or restored as expressed below and in conformance with the regulations and rules as required in the current manual of survey instructions of the United States Department of Interior, Bureau of Land Management.

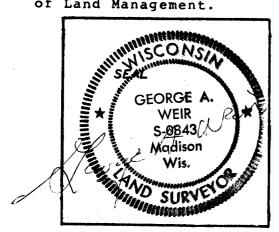

COUNTY SURVEYOR FILING DATA
Date of Computer Entry
Date Received*
Date Microfilmed April 30 1985
Treasurer's Receipt No.
Number of Included Sheets

AFFIX YOUR LAND SURVEYOR SEAL.

EII