
## U.S.

## PUBLIC LAND SURVEY MONUMENT RECORD

For Public Land Survey Corners in: T. \_LN., R. \_12\_E

CORNER CODE INDEX

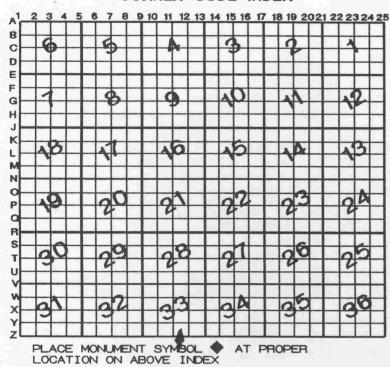

WI ADMINISTRATIVE CODE A-E 7.08 REQUIREMENT

## ROCK COUNTY WI

IF AVAILABLE ROCK COUNTY COORDINATES PERFERRED

North 201, 136.14 Elev.

East 478, 054.35

Hor. Datum COUNTY Vert. Datum \_\_\_

ELLIPS. HT. LATITUDE

LONGITUTE

GPS (X) \_\_\_ TRAVERSE (X)

BASED ON THE FOLLOWING CONTROL:

**♦** CORNER MONUMENT

O WITNESS MONUMENT

BEARINGS ARE BASED

(a)

		/
FIELD BOOKPAGE #	SHEET	_ OF /
SHOW A PLAN VIEW DRAWING DEPICTING THE CORNER MONUMENT		iG '
PHYSICAL FEATURES, INCLUDING THE EXCAVATION AREA AND DEPT	H.	
PLANNING & ZONING COMMITTEE ADOPTED THE ABOVE FORM ON 12/2/1982		

CORNER CODE 2 11/12

ILL4017

(B) Describe any record evidence, monument evidence, occupational evidence, testimonial evidence or any other material evidence you considered, and whether the monument was found or placed.

1836 SPAULDING ORIG SURVEY INTERSECTED THE BASE LINE OF THE NORTH WEST TERRITORY AND NORTH BOUNDARY OF ILLINOIS 386.1' EAST OF THE QUARTER SECTION COR ON THE SOUTH BOUNDARY OF SECTION 33 T1N R12 EAST OF THE 4TH P.M. CALLS FOR 1667.16 TO THE W 1/4 COR SEC 1. AT THE 1/4 COR SET A POST AND STONE . SAID STONE IS 15" LONG 10" WIDE AND 3" THICK. SET ONE AND 6" IN THE GROUND WEST SIDE OF POST.

192? TISSANDIER SET CONCRETE MONUMENT WITH BRASS PLUG. LAT 42 30' 21.12" LONG 89 06' 9.64". 5252.60 TO NW COR SEC 2, 5300.00 TO NE COR SEC 1, ANGLE OF 179-21-15 (CLOCKWISE) FROM NW COR SEC 2 TO NE COR SEC 1.

1940 SHIMEALL MAP #11937 2259.65 TO SE COR SEC 33 1940 SHIMEALL VOL 6 PG 306 5303.40 TO NE COR SEC 1 1983 BARNES VOL 6 PG 306 386.10 TO S 1/4 COR SEC 33

THE FOLLOWING WERE MEASURED: 386.11 (386.11,386.10 REC) TO S 1/4 COR SEC 33 2258.89 (2259.65 REC) TO SE COR SEC 33, ANGEL 180-39-00 (REC 180-38-45) FROM NE COR SEC 1 TO NW COR SEC 2, 5601.52 (5303.40,5300.00 REC) TO NE COR SEC 1, & 5254.21 (5252.60,5254.08 REC) TO NW COR SEC 2.

- C) Was the corner restored through acceptance of (1) an obliterated evidence location, or, (2) a found perpetuated location?
- D) Describe any material discrepancy between the location of the corner as restored or reestablished and the location of that corner as previously restored or reestablished by distance and direction. Show the discrepancy on the plan view drawing under (a), above. Show the distances between the corner as previously restored or reestablished and (1) the corner as restored or reestablished, and (2) to at least 4 of the witness monuments shown on the drawing in (a), above.
- (E) Was the corner reestablished through lost corner proportionate methods? If so, show the method, including the directions and distances to other public land survey corners used as evidence or used for proportioning the corner location.

I, Donald Barnes, hereby certify that the corner points as identified by the corner code index were, in a field survey on, established, reestablished, monumented, re-monumented, recovered or restored as expressed below and in conformance with the regulations and rules as required in the current manual of survey instructions of the United \* States Department of Interior, Bureau of Land Management.

Pullbaines Oct 20,1998 COUNTY SURVEYOR FILING DATA

Date of computer entry\_\_\_\_\_

Date microfilmed \_\_\_\_\_

Number of included sheets \_\_\_\_\_//2