

Paper weight-110# (minimum)

Black nonfading ink required

U.S. PUBLIC LAND SURVEY MONUMENT RECORD

For Public Land Survey Corners In:

WI ADMINISTRATIVE CODE A-E 7.08 REQUIREMENT

T. 4 N. R. 12 E. 4th P.M.

REV 10/23/2004

USMONREC.DWG

CORNER CODE INDEX

FULTON TWP
ROCK COUNTY WI

IF AVAILABLE
ROCK COUNTY COORDINATES PREFERRED

North _____ Elev. _____

East _____

Hor. Datum _____ Vert. Datum _____

LATITUDE _____ ELLIPS. HT. _____

LONGITUDE _____

NAD83(91) _____ NETWORK ADJ. YR _____

GPS (X) _____ TRAVERSE (X) _____

BASED ON THE FOLLOWING CONTROL:

A	1	2	3	4	5	6	7	8	9	10	11	12	13	14	15	16	17	18	19	20	21	22	23	24	25	A	
B		6				5				4					3					2						1	B
C																											C
D																											D
E																											E
F																											F
G																											G
H																											H
J																											J
K																											K
L																											L
M																											M
N																											N
O																											O
P																											P
Q																											Q
R																											R
S																											S
T																											T
U																											U
V																											V
W																											W
X																											X
Y																											Y
Z																											Z

PLACE MONUMENT SYMBOL AT PROPER LOCATION ON ABOVE INDEX

CORNER MONUMENT

WITNESS MONUMENT

(a)

BEARINGS ARE BASED ON: -----

FIELD BOOK _____ PAGE # _____

SHEET 1 OF 3

SHOW A PLAN VIEW DRAWING DEPICTING THE CORNER MONUMENT AND SURROUNDING PHYSICAL FEATURES, INCLUDING THE EXCAVATION AREA AND DEPTH.

PLANNING & ZONING COMMITTEE ADOPTED THIS FORM ON 12/2/1982

CORNER CODE P-25

FU580^

(B) Describe any record evidence, monument evidence, occupational evidence, testimonial evidence or any other material evidence you considered, and whether the monument was found or placed.

1836 OCT BRINK NORTH EAST SIDE SECTION 24 T4N R12E 4TH
MERIDIAN

2341.02 BUR OAK 12 IN DIAMETER

2640 SET QUARTER SECTION POST BUR OAK 20 N86W
28.38' BUR OAK 10 S27W 73.92'

4928.88 BUR OAK 12 IN DIAMETER

5280 SET POST CORNER SECTIONS 13 & 24 BUR OAK 10
N8W 60.06' BLACK OAK 17 S33W 14.52' LAND
ROLLING SECOND RATE BUR WHITE & BLACK OAK
RED ROOT ROSIN WEED & C

1842 PIERCE TWP RD JV BK 1 PG 11 SURVEYED A ROAD BEGINNING
AT THE RANGE LINE AND AT THE CORNER OF SEC 24 AND
THENCE SOUTHEAST COR OF 13 IN T4N R12E FROM SAID COR
ON THE SEC LINE TO THE QUARTER STAKE S88-15W 2640;
THENCE N45-45W 1254'; THENCE N86-45W 1056'; THENCE
N59-45W 759'; THENCE N89-45W 2277'; THENCE S69-15W
1089'; THENCE N82-45W 462'; THENCE N68-15W 1023';
THENCE S86-30W 594'; THENCE S53-15W 1023'; THENCE
S30-15W 554.4; THENCE S53-15W 1023'; THENCE S30-15W
554.4; THENCE S89-45W 5748.6 ON; THENCE N79-45W 990'
ON SECTION LINE THENCE; S74-45W 999.9' TO THE PLACE
DESCRIBED AS THE PLACE OF BEGINNING FOR THE ABOVE
DESCRIBED ROAD MAKING 3 MILE 4629.9'

1866 LOCKE VOL 1 PG 272 & #2959 FD STUMPS OF BTS & OLD
STAKE OF QUARTER POST SET BY TOWNSHIP MON. 2330.86
TO GEN SEC19 MILTON TWP

1871 (AUG22) RUGER MILTON TWP REMON. NORTH ON WEST LINE OF
SW 1/4 OF SEC 19 ON A VAR 6-05 AT

2670.36 INTERSECTED 1/4 LINE 3.3' WEST OF 1/4 COR. FOUND
STAKE AT COR. ALSO FOUND STUMPS OF BEARING
TREES COR VAR 6-01

NORTH ON WEST LINE OF N.W. 1/4 OF SEC 19
ON A VAR 6-00 AT

2675.64 INTERSECTED NORTH BOUNDARY LINE 4.62' EAST
OF COR. FOUND OLD STAKE AT COR. ALSO FOUND
STUMPS OF BEARING TREES. COR VAR 6-06
PLACED 6"X6" CUT LIMESTONE

189? BROWN VOL 2 PG 501 CALLS FOR MON BUT STATES NOTHING
IT.

1974 LEE VOL 5 PG 41 FD CUT STONE & REF SAME. ON LINE E/W
FENCE LINE.

1980 BARNES VOL 6 PG 25 FD CUT L.S. 0.5' ABOVE GROUND IN N/S
FENCE ROW

1983 BARNES P-1 SET BERNTSEN W-1-C OVER CUT LIMESTONE (30"
DEEP) & REF. SAME. ON LINE WITH E/W FENCE LINE IN PVMT.

1983 BARNES REMON #6794 NO-16-49E 2678.10 TO NE COR SEC
24, S0-35-41W 2672.06 TO SE COR SEC 24

1988 SCHROEDER CSM VOL 13 PG 374 STATES NOTHING ABOUT
MON.

1990 SCHROEDER CSM VOL 14 PG 276 & 404 STATES NOTHING
ABOUT MON.

1992 COMBS CSM VOL 16 PG 8 ALUM. MON.

1998 COMBS CSM VOL 21 PG 283 FD ALUM. MON. 2671.93 TO SE
COR SEC 24.

2001 COMBS #14254 FD ALUM. MON 2678.19 TO NE COR SEC 24

SHEET 1 OF 3
CORNER CODE P-25

Donald
Barnes

11/13/07

FU580

FD POLY WITH TOP BROKE OFF & REFERENCE MONUMENTS.

C) Was the corner restored through acceptance of (1) an obliterated evidence location, or, (2) a found perpetuated location?

ACCEPTED FD MON.


D) Describe any material discrepancy between the location of the corner as restored or reestablished and the location of that corner as previously restored or reestablished by distance and direction. Show the discrepancy on the plan view drawing under (a), above. Show the distances between the corner as previously restored or reestablished and (1) the corner as restored or reestablished, and (2) to at least 4 of the witness monuments shown on the drawing in (a), above.

NONE

(E) Was the corner reestablished through lost corner proportionate methods? If so, show the method, including the directions and distances to other public land survey corners used as evidence or used for proportioning the corner location.

NO


I, **Donald Barnes**, hereby certify that the corner location as identified by the corner code index was determined by me under my direction and control and that this U.S. Public Land Survey Monument Record is correct and complete to the best of my knowledge and belief.

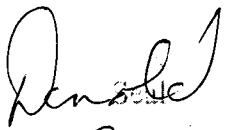
Donald Barnes
Emboss
11/13/07

SHEET 2 OF 3

CORNER CODE **P-25**

A.E. 7.08 REQUIREMENT

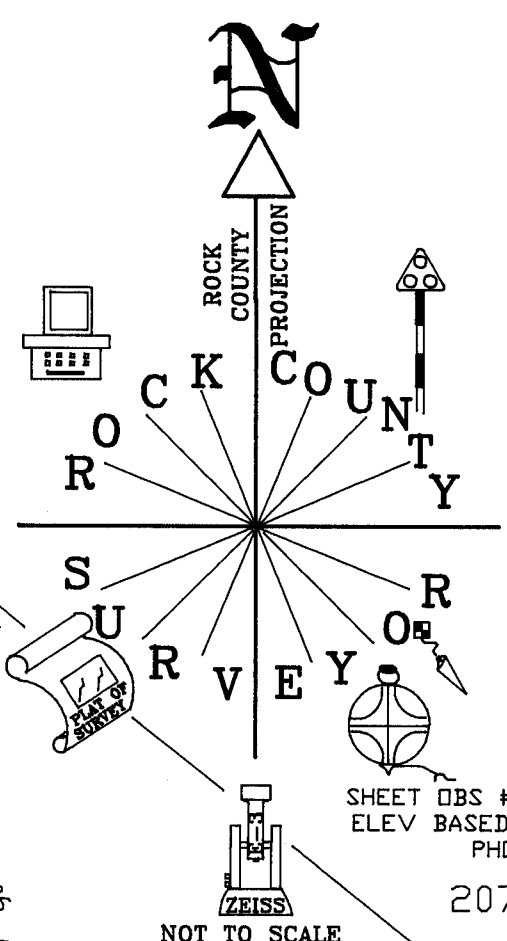

3/4X24 REROD
7.4' WEST OF
WEST PVMT EDGE
& 26' +/- SOUTH
OF CEN. OF DR

FULTON TWP
T4N R12E
SEC 24

2076

N03-20-53W 643.36

S00-59-24E 659.06

ANT
N81-58-06W 11.40X'

SHEET OBS #2076 & 2077
ELEV BASED ON DIGITAL
PHOTO

2077

NOT TO SCALE

ELEV 874.8
FD PIPE

E 1/4 COR
SEC 24

ELEV 872.2
FD BENT PIPE
REPLACED WITH
3/4X24 REROD

XXXXXXXXXXXXXX

FARM FIELD

1974 22
1983 21.99
N82-47-11E
21.73

FD POLY WITH
TOP BROKE OFF
ELEV 873.1

MILTON TWP
T4N R13E
SEC 19

N67-51-34E 51.54
1974 51.86

1974 31.10
1983 31.10
N57-28-41E 31.06

1974 57.62
N02-04-05E 57.64

FARM FIELD

N02-05-56E 36.20
1974 36.74

1974 45.50
1983 45.50
N30-27-47E 45.13

1974 47.51
1983 47.51
S30-30-26E 47.48

ELEV 871.1
DID NOT FD
PIPE. SET
3/4" PIPE

1974 46.82
S87-32-50E 47.03

NEWVILLE RD
E 1/4 COR
SEC 24

ELEV 871.8
FD PIPE

SHEET 3 OF 3

EMBOSSSED
SEAL

Donald Barnes

11/13/07

P-25