

# U.S. PUBLIC LAND SURVEY MONUMENT RECORD

For Public Land Survey Corners in:

WI ADMINISTRATIVE CODE A-E 7.08 REQUIREMENT

T. 5 N., R. 13 E

### CORNER CODE INDEX

|   |    |    |   |   |   |   |   |   |   |    |    |    |    |    |    |    |    |    |    |    |    |    |    |    |    |
|---|----|----|---|---|---|---|---|---|---|----|----|----|----|----|----|----|----|----|----|----|----|----|----|----|----|
| A | 1  | 2  | 3 | 4 | 5 | 6 | 7 | 8 | 9 | 10 | 11 | 12 | 13 | 14 | 15 | 16 | 17 | 18 | 19 | 20 | 21 | 22 | 23 | 24 | 25 |
| B |    |    |   |   |   |   |   |   |   |    |    |    |    |    |    |    |    |    |    |    |    |    |    |    |    |
| C | 6  |    |   |   |   |   |   |   |   |    |    |    |    |    |    |    |    |    |    |    |    |    |    |    |    |
| D |    |    |   |   |   |   |   |   |   |    |    |    |    |    |    |    |    |    |    |    |    |    |    |    |    |
| E |    |    |   |   |   |   |   |   |   |    |    |    |    |    |    |    |    |    |    |    |    |    |    |    |    |
| F | 7  |    |   |   |   |   |   |   |   |    |    |    |    |    |    |    |    |    |    |    |    |    |    |    |    |
| G |    |    |   |   |   |   |   |   |   |    |    |    |    |    |    |    |    |    |    |    |    |    |    |    |    |
| H |    | 8  |   |   |   |   |   |   |   |    |    |    |    |    |    |    |    |    |    |    |    |    |    |    |    |
| J |    |    |   |   |   |   |   |   |   |    |    |    |    |    |    |    |    |    |    |    |    |    |    |    |    |
| K | 18 |    |   |   |   |   |   |   |   |    |    |    |    |    |    |    |    |    |    |    |    |    |    |    |    |
| L |    |    |   |   |   |   |   |   |   |    |    |    |    |    |    |    |    |    |    |    |    |    |    |    |    |
| M |    | 11 |   |   |   |   |   |   |   |    |    |    |    |    |    |    |    |    |    |    |    |    |    |    |    |
| N |    |    |   |   |   |   |   |   |   |    |    |    |    |    |    |    |    |    |    |    |    |    |    |    |    |
| O |    |    |   |   |   |   |   |   |   |    |    |    |    |    |    |    |    |    |    |    |    |    |    |    |    |
| P | 19 |    |   |   |   |   |   |   |   |    |    |    |    |    |    |    |    |    |    |    |    |    |    |    |    |
| Q |    |    |   |   |   |   |   |   |   |    |    |    |    |    |    |    |    |    |    |    |    |    |    |    |    |
| R |    | 20 |   |   |   |   |   |   |   |    |    |    |    |    |    |    |    |    |    |    |    |    |    |    |    |
| S |    |    |   |   |   |   |   |   |   |    |    |    |    |    |    |    |    |    |    |    |    |    |    |    |    |
| T | 30 |    |   |   |   |   |   |   |   |    |    |    |    |    |    |    |    |    |    |    |    |    |    |    |    |
| U |    |    |   |   |   |   |   |   |   |    |    |    |    |    |    |    |    |    |    |    |    |    |    |    |    |
| V |    | 29 |   |   |   |   |   |   |   |    |    |    |    |    |    |    |    |    |    |    |    |    |    |    |    |
| W |    |    |   |   |   |   |   |   |   |    |    |    |    |    |    |    |    |    |    |    |    |    |    |    |    |
| X | 31 |    |   |   |   |   |   |   |   |    |    |    |    |    |    |    |    |    |    |    |    |    |    |    |    |
| Y |    |    |   |   |   |   |   |   |   |    |    |    |    |    |    |    |    |    |    |    |    |    |    |    |    |
| Z |    | 32 |   |   |   |   |   |   |   |    |    |    |    |    |    |    |    |    |    |    |    |    |    |    |    |

KUSHKONONG TWP

ROCK COUNTY WI

IF AVAILABLE  
ROCK COUNTY COORDINATES PREFERRED

North \_\_\_\_\_ Elev. \_\_\_\_\_

East \_\_\_\_\_

Hor. Datum \_\_\_\_\_ Vert. Datum \_\_\_\_\_

LATITUDE \_\_\_\_\_ ELLIPS. HT. \_\_\_\_\_

LONGITUDE \_\_\_\_\_

GPS (X) \_\_\_\_\_ TRAVERSE (X) \_\_\_\_\_

BASED ON THE FOLLOWING CONTROL:

PLACE MONUMENT SYMBOL  $\blacklozenge$  AT PROPER LOCATION ON ABOVE INDEX

$\blacklozenge$  CORNER MONUMENT

$\circ$  WITNESS MONUMENT

(a)

THOMAS WOLLIN, JEFFERSON COUNTY SURVEYOR,  
PROVIDED THE STATE PLANE COORDINATES FOR  
CORNER CODE #7701 CORSE SEC 35 T5N R13E

STATE PLANE COORDINATES N/S 310, 286.406  
NAD 1983/91 OF RECORD E/W 2, 259, 601, 329

I DONALD BARNES CONVERTED THE ABOVE  
COORDINATES TO THE FOLLOWING:

LATITUDE 42-50-46.08437  
LONGITUDE 88-54-52.24591  
MERIDIAN CONV. 0-44-45.0  
SCALE FACTOR 0.9999791682

ROCK COUNTY COORDINATES (NAD 1983/91)

N/S 328, 660, 963  
E/W 522, 297, 355  
SCALE 0.9999980438

CONVERGENCE: THE ANGULAR DIFFERENCE  
BETWEEN THE GEODETIC NORTH & THE ROCK  
COUNTY MERCATOR NORTH

$\ominus$  1- DEG 0 MIN 06 SEC 26.1

BEARINGS ARE BASED ON:

*Donald Barnes*

2/12/03

FIELD BOOK \_\_\_\_\_ PAGE # \_\_\_\_\_

SHEET 1 OF 1

SHOW A PLAN VIEW DRAWING DEPICTING THE CORNER MONUMENT AND SURROUNDING  
PHYSICAL FEATURES, INCLUDING THE EXCAVATION AREA AND DEPTH.

PLANNING & ZONING COMMITTEE ADOPTED THE ABOVE FORM ON 12/2/1982

*File in MILTON TWP*


**CORNER CODE** A-21/22

# GOVERNMENT LAND CORNER RECORD

## JEFFERSON COUNTY


CORNER NO. 7701

TYPE OF MONUMENT Aluminum Magnetized  
 STATE PLANE COORDINATES NAD 1983/91  
     N. 310286.406 SE-35  
     E. 2259601.329  
 ELEVATION M.S.L. DATUM: \_\_\_\_\_  
 Grid-Ground 1.0000547765  
 FIELD BOOK Koshkonong p. 42  
 DRAWN BY TRW

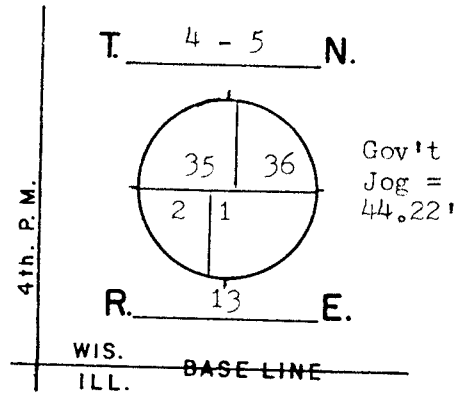

Original Survey, 1834-37, Wood Post & Bearing Trees  
 1871, Resurvey of Milton Township, Limestone Monuments were set. Ref. Rock County Surveyors Office.  
 1886, Resurvey of Koshkonong Township, Limestone Monuments were set. Notes recorded in the Register of Deeds, Misc. Vol. 1, pages 389-412.  
 1972, Koshkonong Resurvey stone was found about 3' below road surface, an iron pipe was set over it.  
 1980, Iron pipe was removed and an Aluminum Monument was set for SE-35. An Aluminum Monument was also set for NE-2 by the Rock County Surveyor.  
 2/8/2002, G.P.S. coordinates are assigned. A Topcon GP-SX1 single-frequency receiver was used.

SEAL:

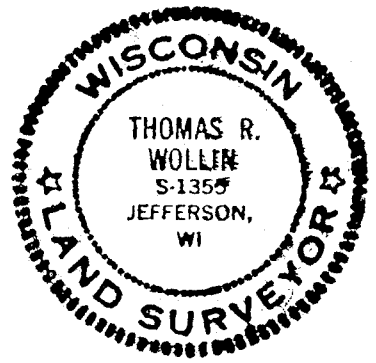


DATA SHOWN HERE ON CERTIFIED CORRECT:

*Thomas R. Wollin*  
 REGISTERED LAND SURVEYOR  
 DATED 2/20/2002

### LOCATION SKETCH

- SQUARE CUT LIMESTONE 5" by 36"
- CONCRETE / BRASS CAP
- ALUMINUM MAGNETIZED 4" by 30"
- IRON PIPE 1" by 24"
- STEEL "T" BAR STAKE
- PK NAIL
- \*\*\* FENCE
- UTILITY POLE
- STEEL POST / SIGN

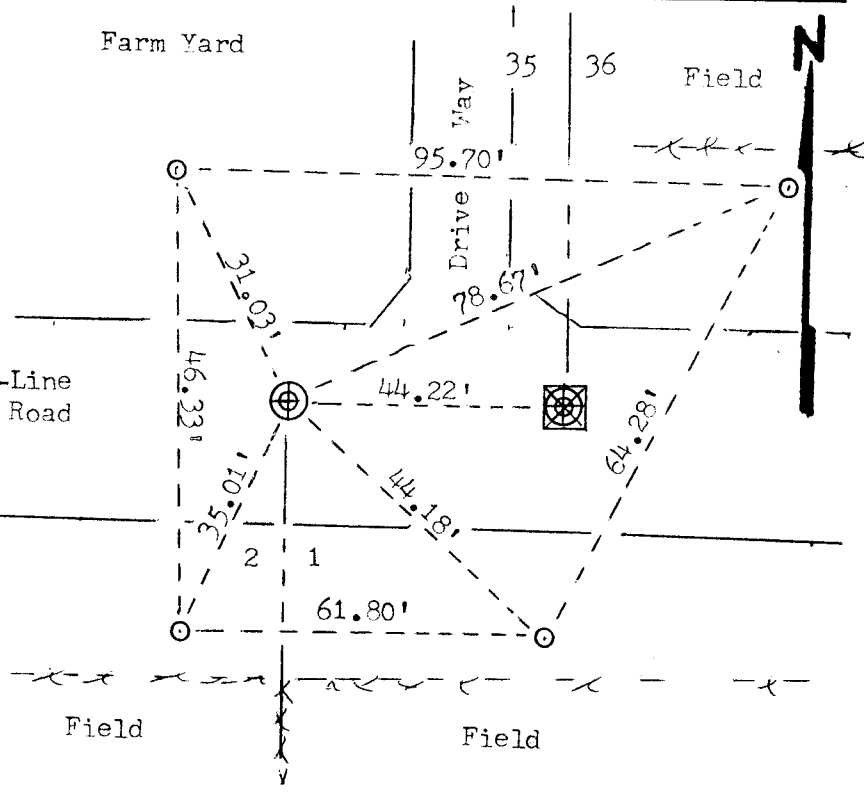

### MAINTENANCE RECORD

| DATE | INIT. | REMARKS |
|------|-------|---------|
|      |       |         |
|      |       |         |
A-21/22