

PLAT AND RECORD


Of a Survey on Sections 16 & 17 T 4 R 10 E. of the 4 P. M. in Union Township

Rock County, Wisconsin, made April the 21st 1890

I hereby certify that the following is a correct record of said survey as made by me.

COUNTY BUILDING
IN CITY OF БЕЛОIT

(Signed) O. G. Bleedorn
RAB Top County Surveyor.

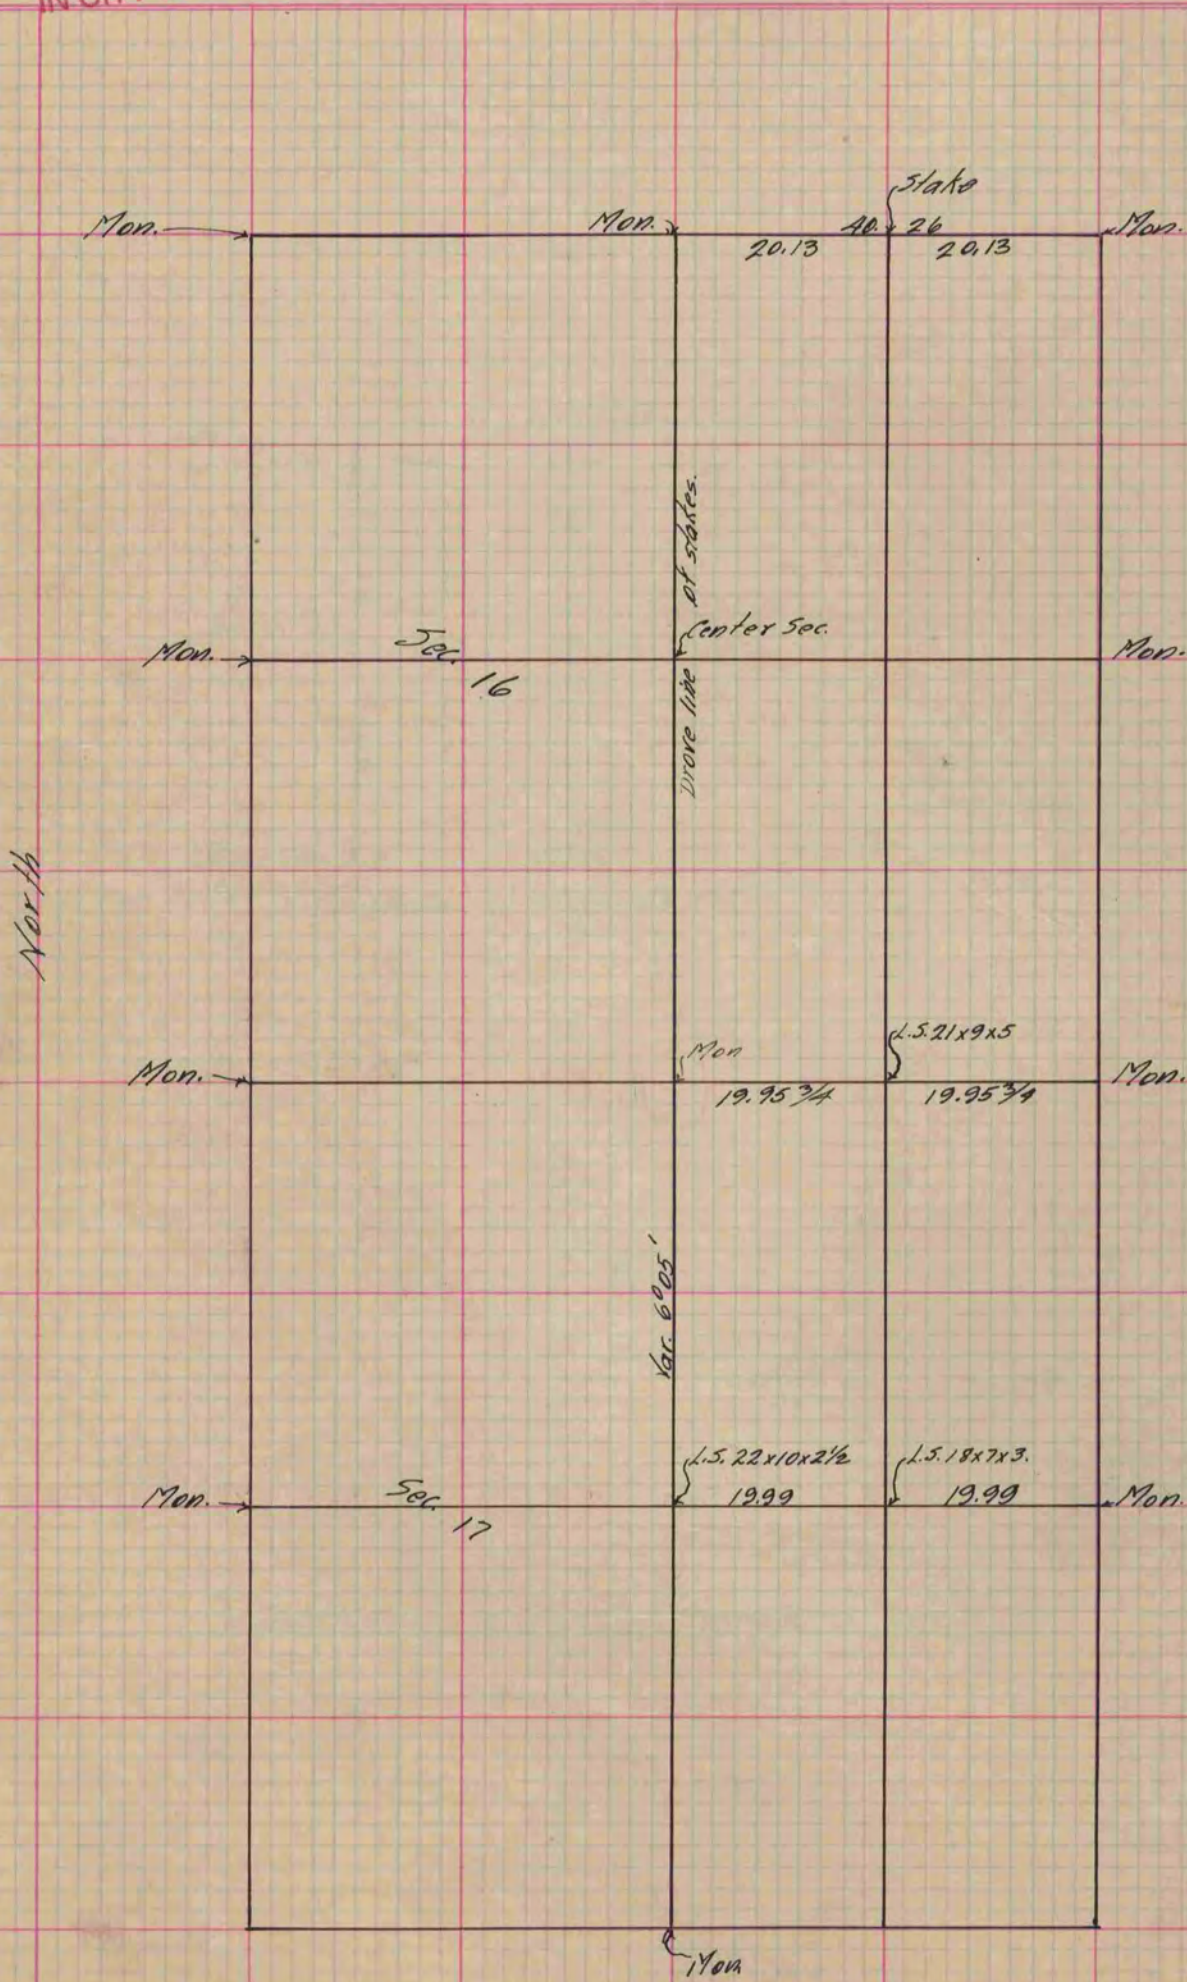

Copied from P. 346 Vol. 2 County Surveyor's Record.