

PLAT AND RECORD


Of a Survey on Sections 20 & 21 T 4 R 10 E. of the 4 P. M. in Union Township

Rock County, Wisconsin, made Jan. 23 + 24 1890
July 13 1893

I hereby certify that the following is a correct record of said survey as made by me.

COUNTY BUILDING
IN CITY OF БЕЛОIT

(Signed) O. G. Bleedorn
Dep. County Surveyor.

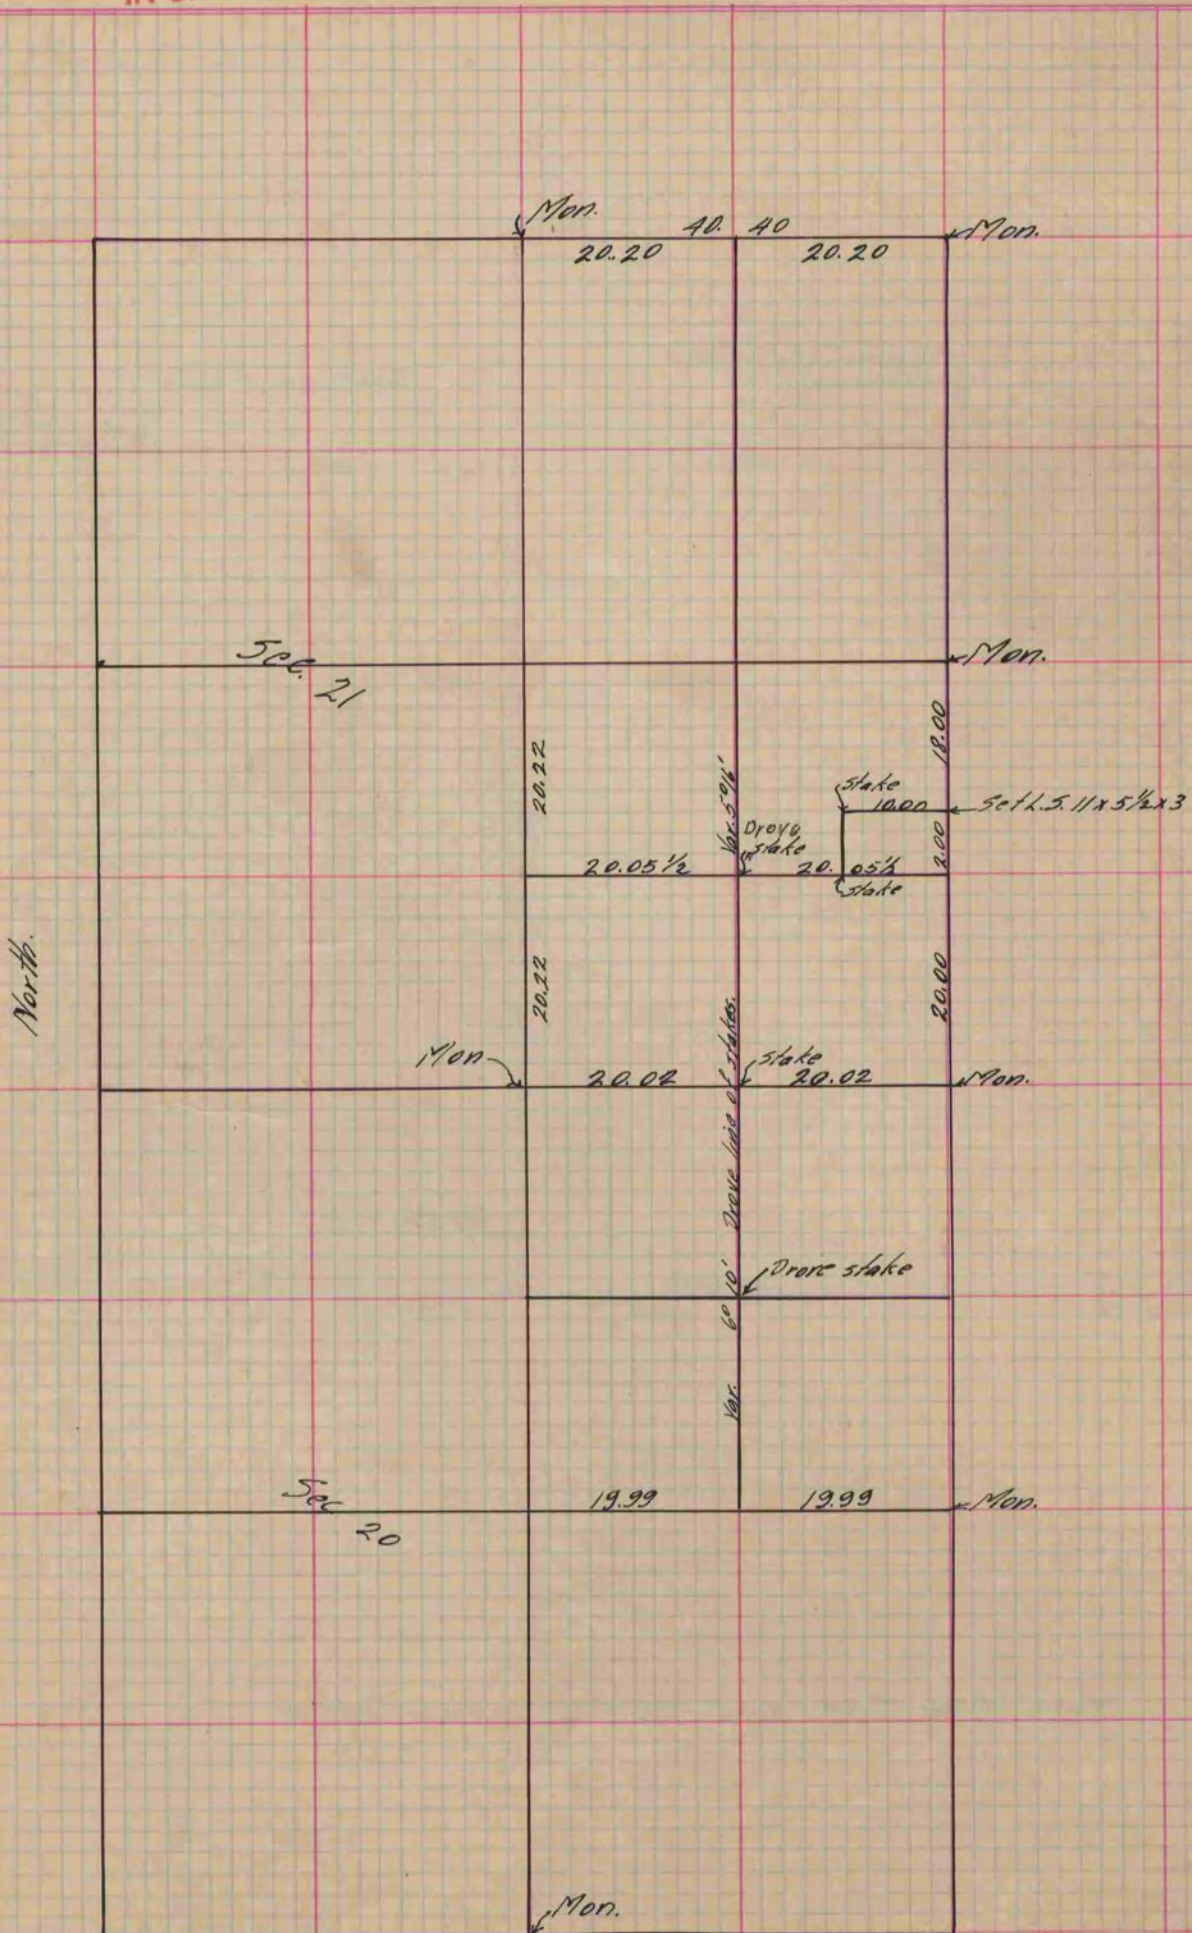

Copied From P. 347 Vol. 2 County Surveyor's Record.