


Of a Survey on Section 34 10 T 1 R 12 E. of the 4 P. M. in Beloit Township
" 34 " 2 " 12 Rock
Rock County, Wisconsin, made June the 18 19 1874

I hereby certify that the following is a correct record of said survey as made by me.

COUNTY BUILDING
IN CITY OF BELOIT

(Signed) Edward Ruger
RUGER

County Surveyor.

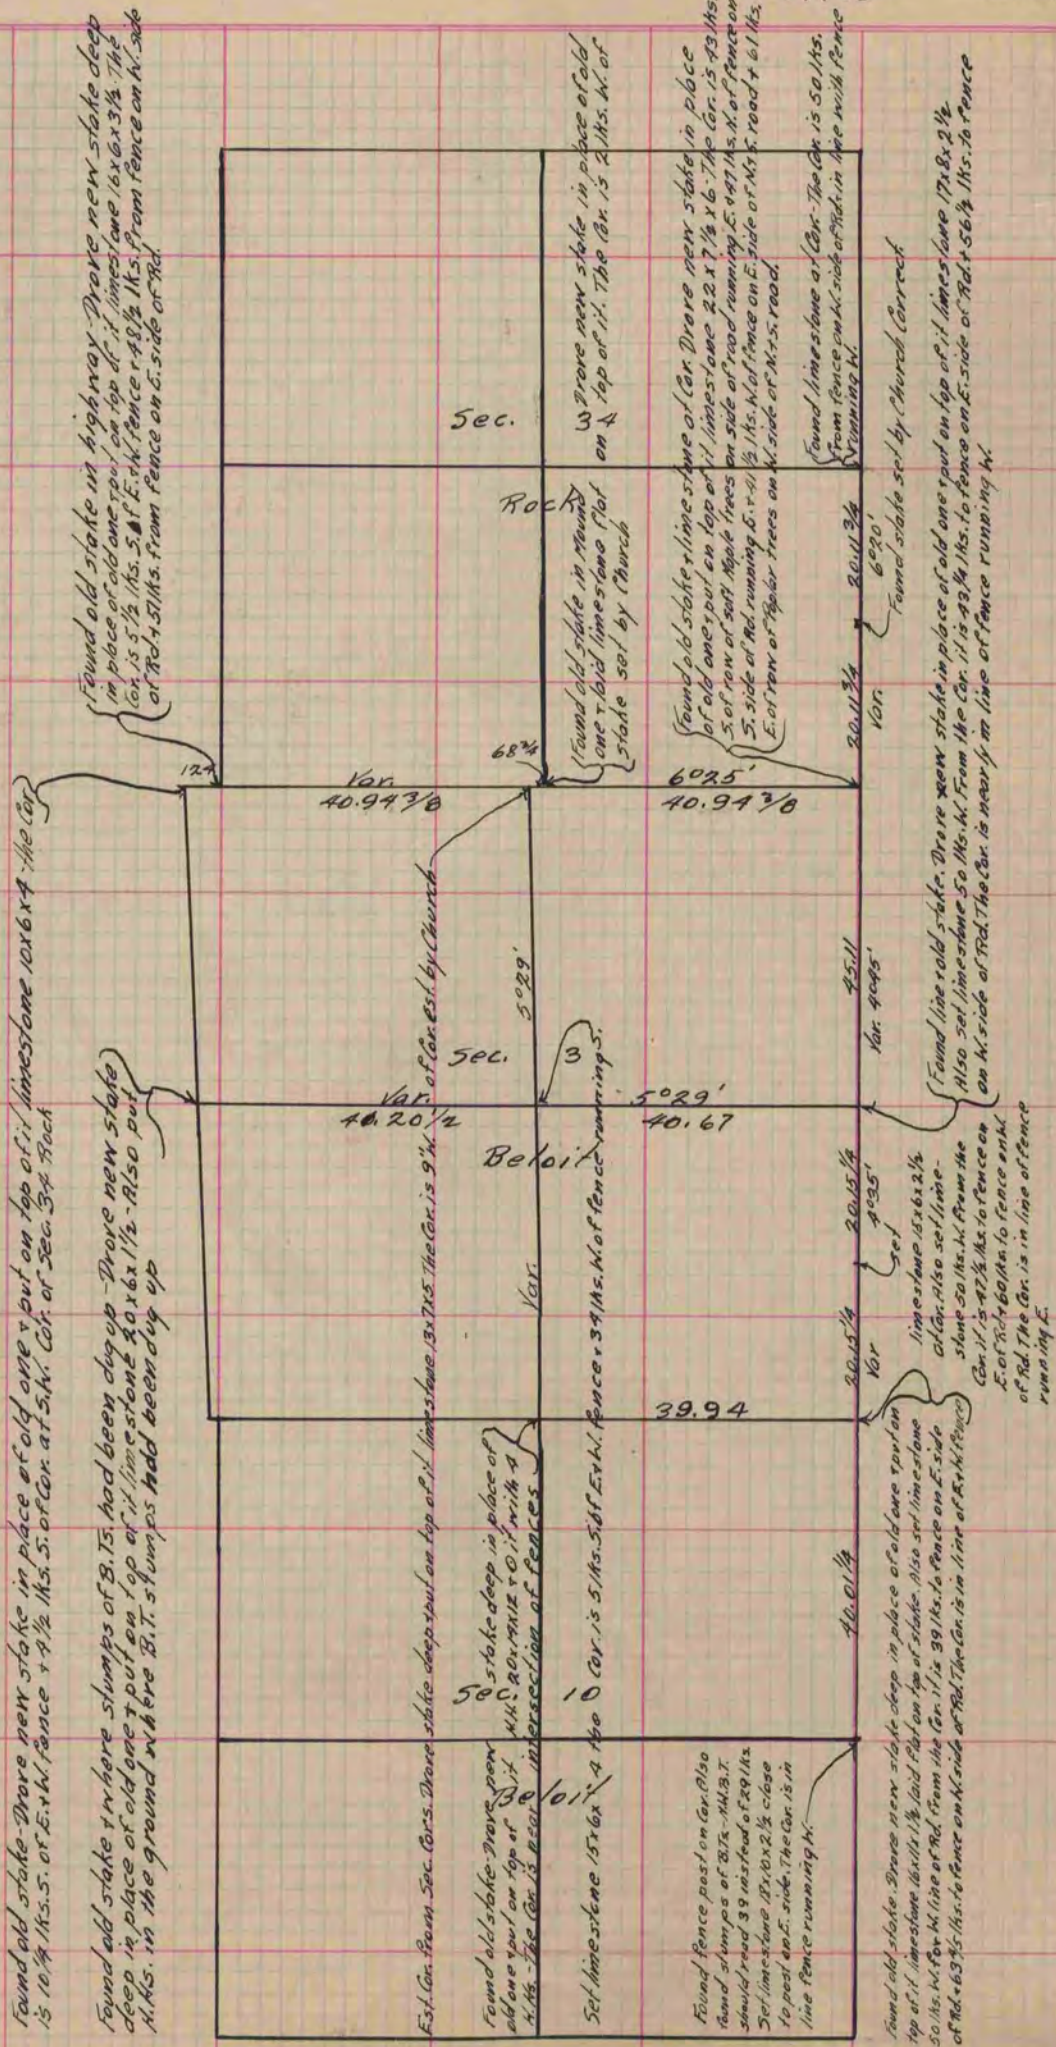

Copied from Page 100 Vol. 2 Original County Surveyor's Record.