

# PLAT AND RECORD


Of a Survey on Section 8 T 1 R 10 E. of the 4 P. M. in AYON Township  
 Rock County, Wisconsin, made June the 23 1874

I hereby certify that the following is a correct record of said survey as made by me.

COUNTY BUILDING  
 IN CITY OF BELOIT

(Signed) Edward Poyer  
Ed P

County Surveyor.

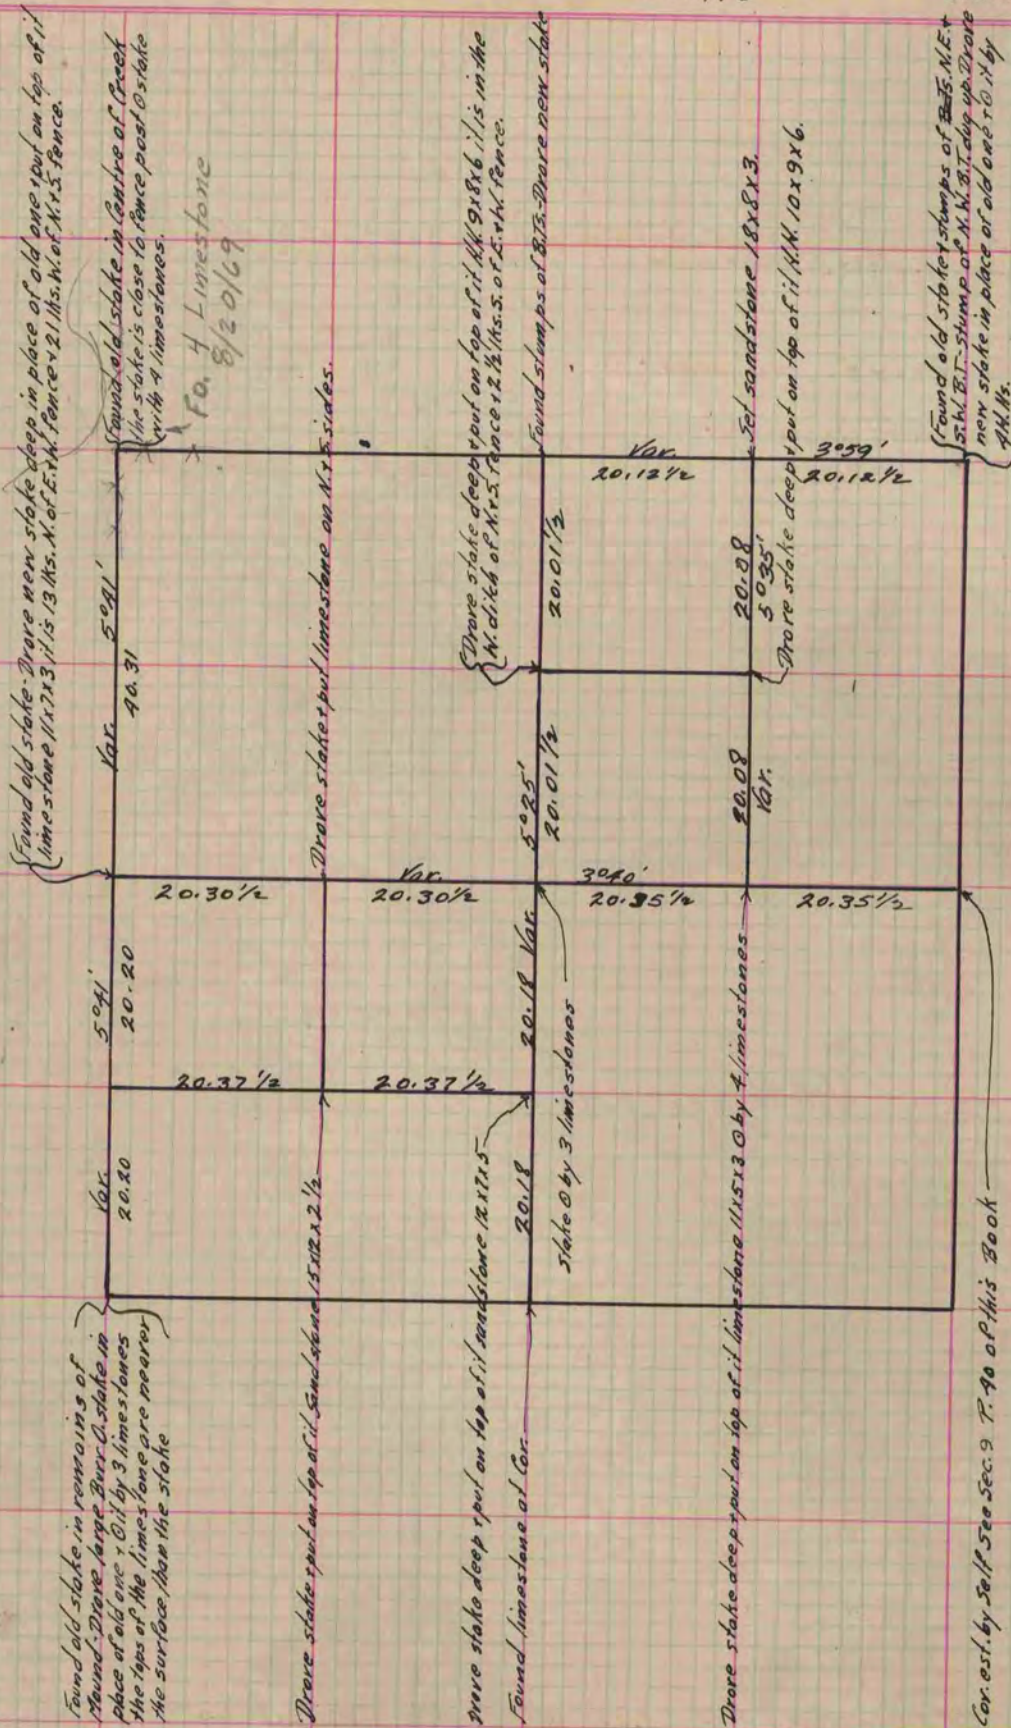

Copied From P. 101 Vol. 2 Original County Surveyor's Record.