

PLAT AND RECORD

571

Of a Survey on Section 33 T 3 R 14 E. of the 4 P. M. in Johnstown Township

Rock County, Wisconsin, made July the 19th 1972



I hereby certify that the following is a correct record of said survey as made by me.

COUNTY BUILDING
IN CITY OF BELOIT

Hugh J. De...

County Surveyor.

THE GEO. D. BARNARD COMPANY, ST. LOUIS

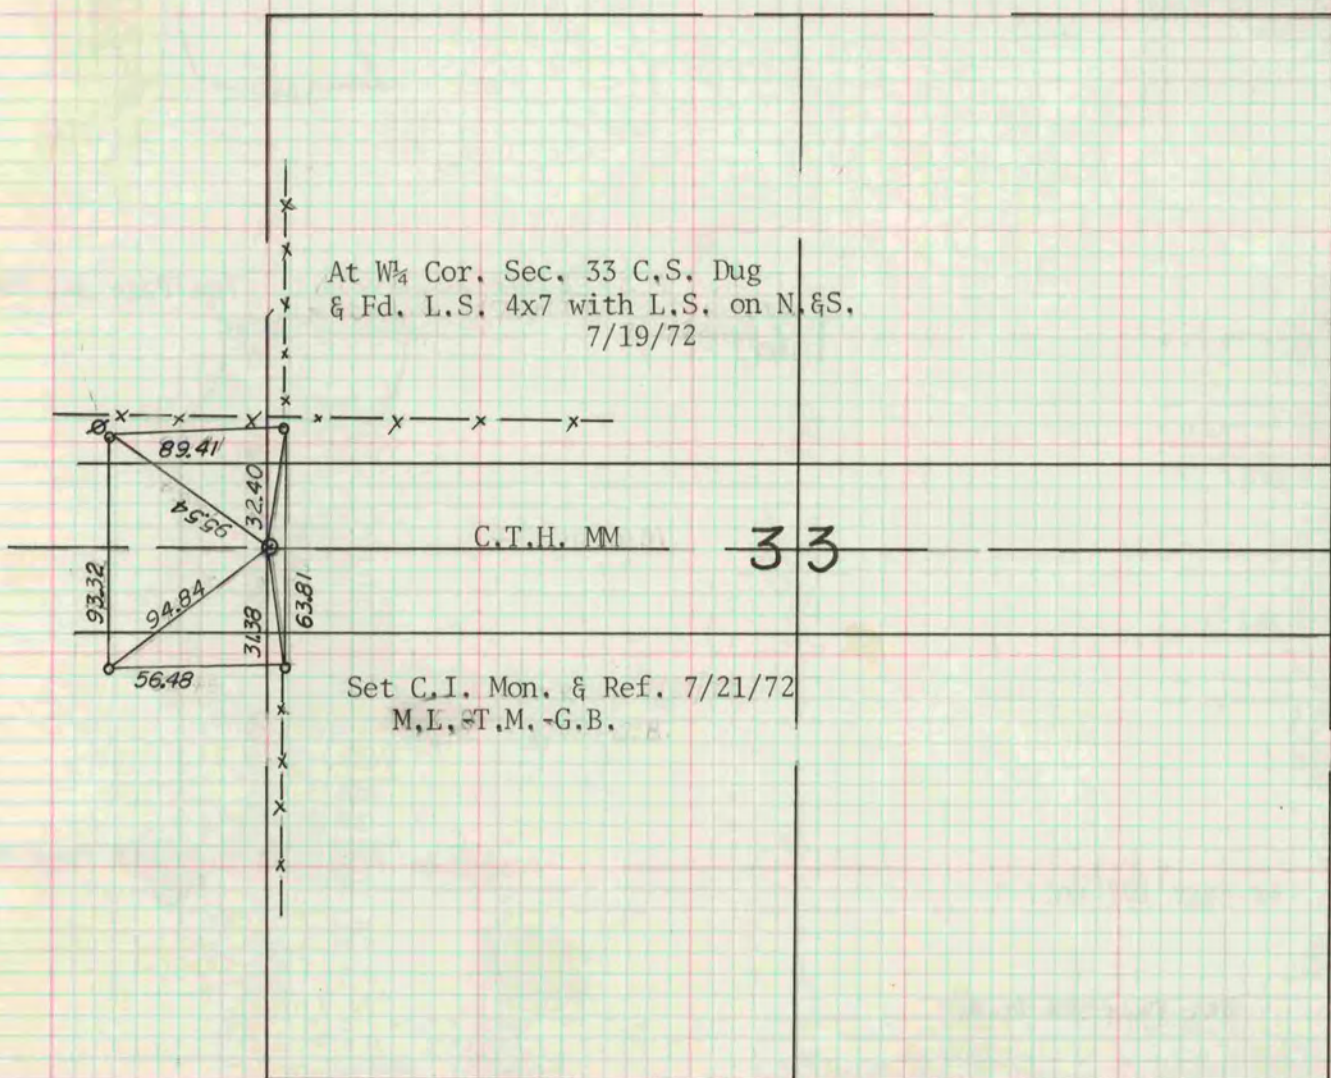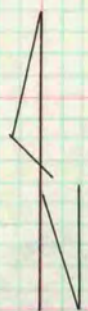

COUNTY BUILDING
IN CITY OF BELOIT