

# PLAT AND RECORD


Of a Survey on Sections 28 & 33 T 3 R 13 E. of the 4 P. M. in Harmony Township  
Rock County, Wisconsin, made June the 19 1882

I hereby certify that the following is a correct record of said survey as made by me.

COUNTY BUILDING  
IN CITY OF BELOIT

(Signed) Edward Ruger  
ERM

County Surveyor.

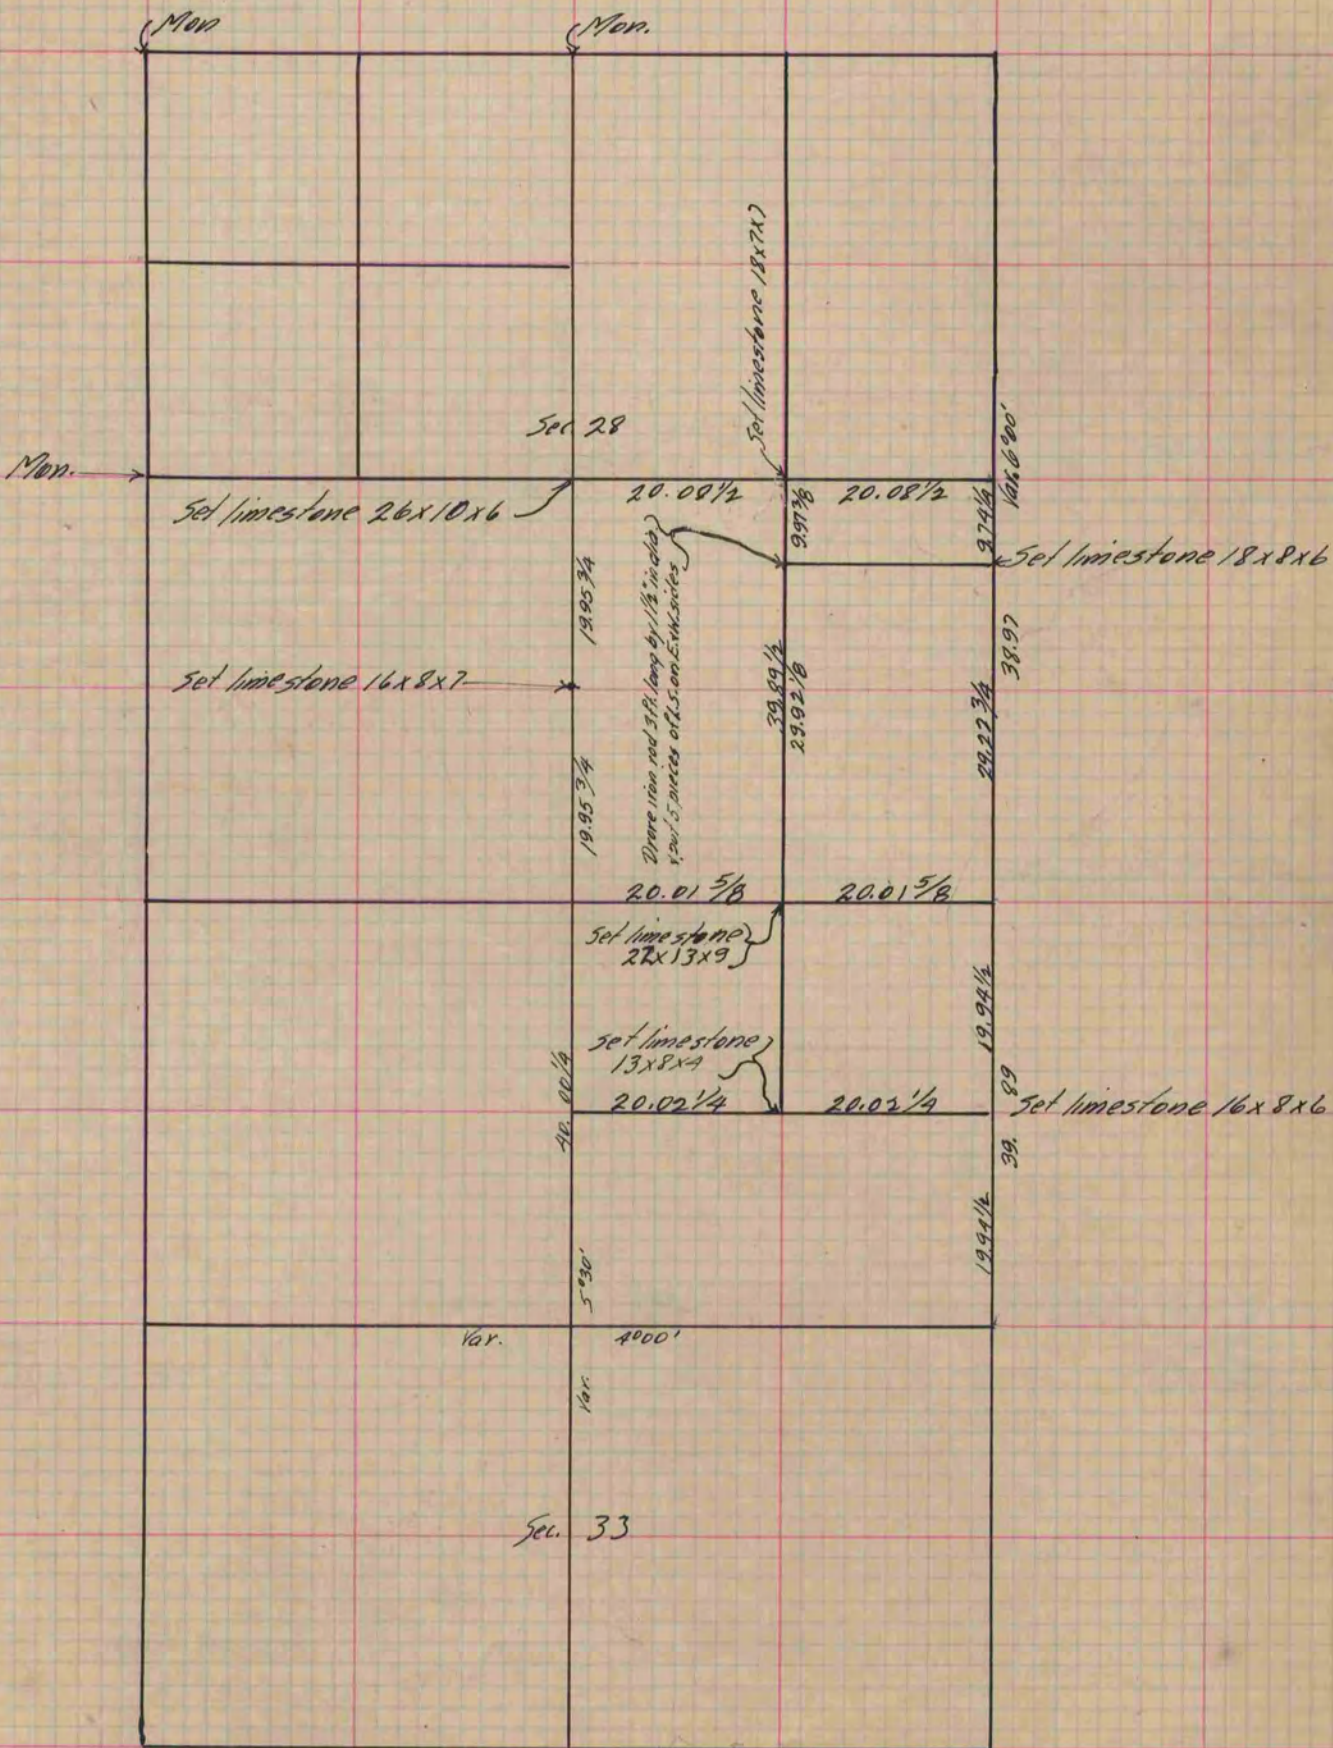

See P. 182

Copied From P. 327 Vol. 2 County Surveyor's Record.