


PLAT AND RECORD

Of a Survey on Section ^{SE 1/4} 30 T 3 R 13 E. of the 4th P. M. in Harmony Township
 Rock County, Wisconsin, made Aug. the 21 1891

I hereby certify that the following is a correct record of said survey as made by me.

COUNTY BUILDING
 IN CITY OF BELOIT

(Signed) O.G. Bledorn
 dep. County Surveyor.

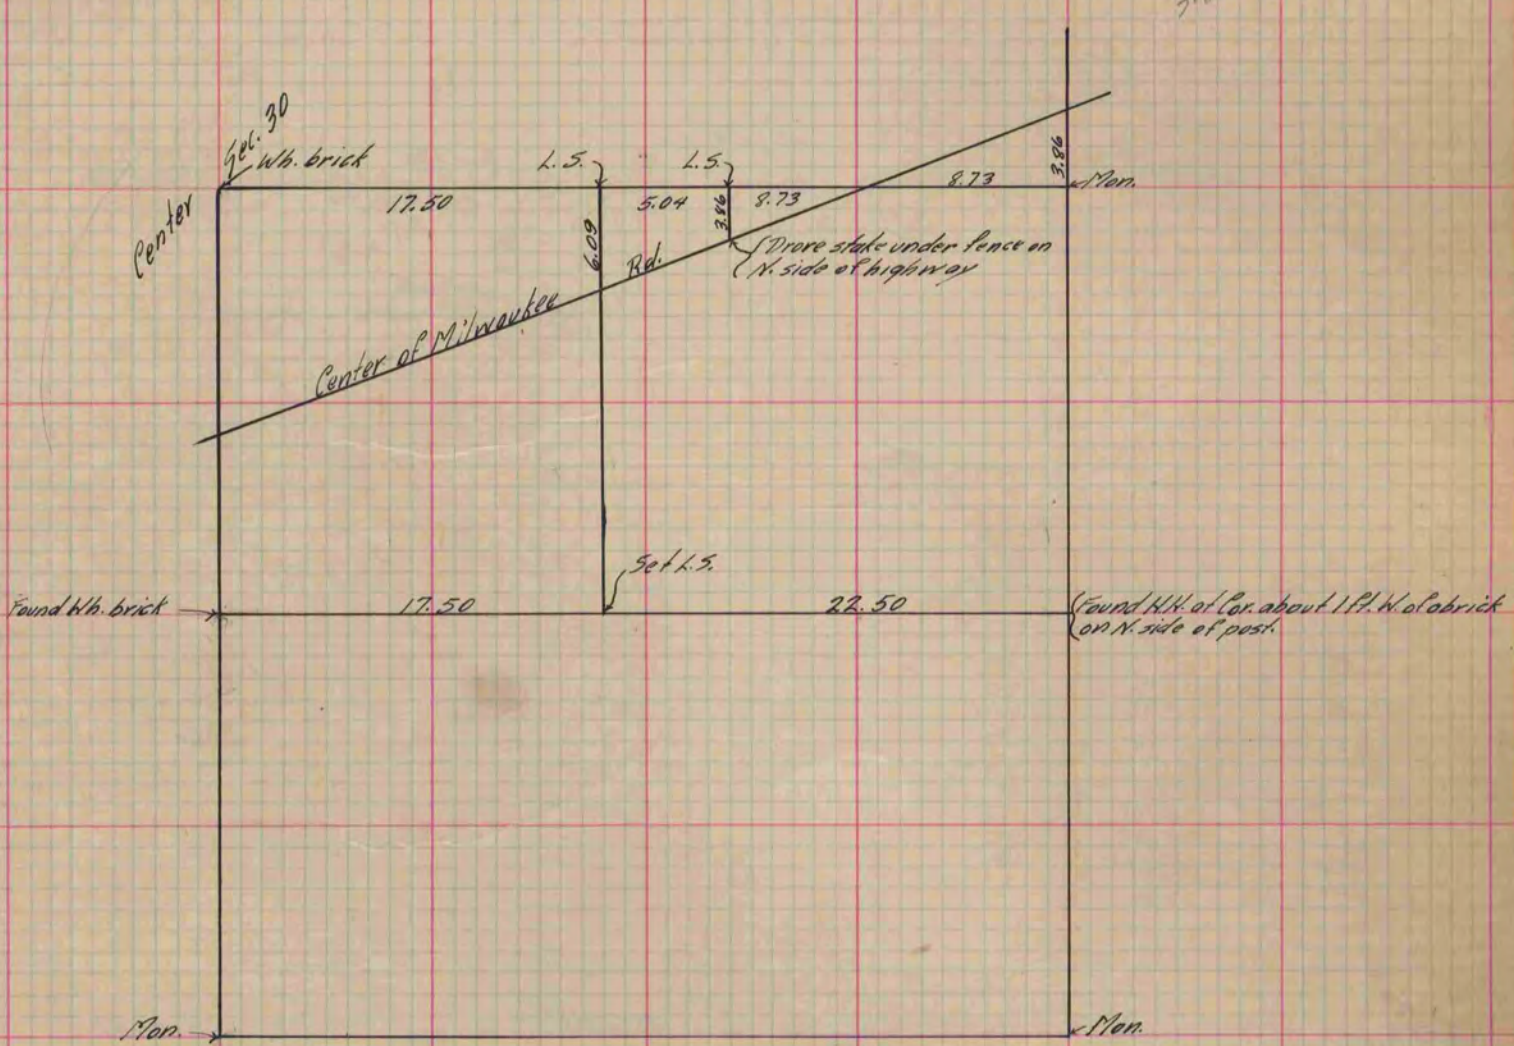

Copied from P. 360 Vol. 2 County Surveyor's Record.